

Section 20 Township 9 Range 18WWell No. 3 Baumgartner "B"Company Heathman & Seeligson

NORTH

				0			

SOUTH

WEST

EAST

Rooks KANSAS

SEC.	TWP.	R.
20	9	18 W

✓

WELL NO.

COMPANY # 3 Baumgartner "B" FARM

CONTRACTOR Heathman & Seeligson

Co. tools

Paradise Creek Pool


990 Ft. from N. Line

Ft. from S. Line

Ft. from E. Line

330 Ft. from W. Line

SW NW NE

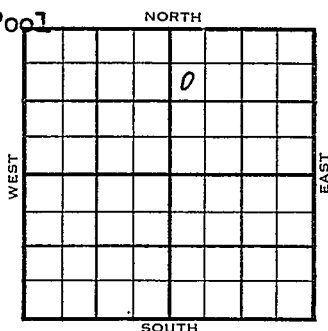

ELEVATION	REPORT
1954 2172'	

1/13	Spud 1-11-54 8" @ 171 WOC
1/20	Anhy 1521', Top 3109', Heeb 3321', Lans 3361' Drlg. 3488'
1/27	Spud 1-11-54 D & A TD 3642' 8" @ 171 Anhy 1521 Top 3109 Heeb 3321 Lans 3361 Arb. 3604 DST 3607-15 open 3/4 hr rec 2' mud 0# DST 3607-25 open 1 hr rec 30' mud 150# DST 3620-32 open 1/2 hr rec 12' mud 1040# TD 3642' D & A

ABANDONED

County Rooks State Kansas

Sec. 20 (Blk. 9 (Sur. 18W Map No.

Operator Reethman & Seelinson

Well No. 3 Farm Baumgartner "B"

Elev.	Location	SW	NW	NE
-------	----------	----	----	----

			0	
FIRST	REPORT			

990 Ft. From W Line NH

330 Ft. From ~~to~~ Line Quarter

1st. Report JAN 13 1954

Completion

Remarks

Co. tools

Spudding Date **1-11-54**

Drlg. Data Paradise Creek Pool

8" @ 171 WOC

J. G. McGEHEE

J. G. McGEHEE