FORM 51 Rooks KANSAS

Section 20 Township 9 Range 18 W

Well No. # 4 Baumgartner "B"

Company Heathman & Co.

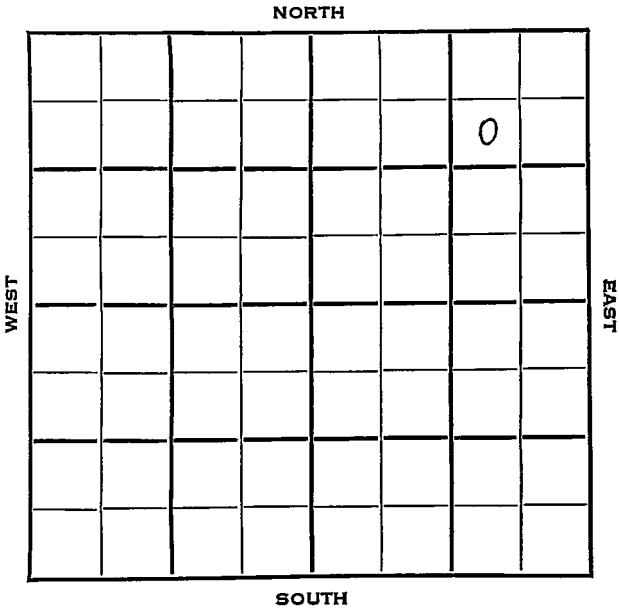

Rooks KANSAS

| SEC. | TWP. | R. |
|---|---|---|
| 20 | 9 | 18 W |

WELL NO.

# 4 Baumgartner "B" FARM

COMPANY

Heathman & Co.

CONTRACTOR

~~Baumgartner~~

Baumgartner Pool

990 Ft. from N. Line

Ft. from S. Line

990 Ft. from E. Line

Ft. from W. Line

SW NE NE

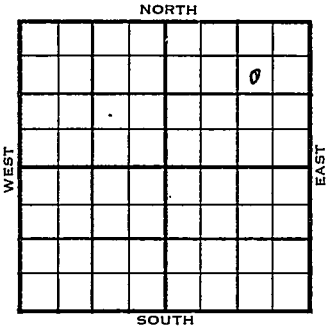


| 1954 | ELEVATION - REPORT |
|---|---|
| 2/3 | Spud 1-29-54<br>8" @ 155 Anhy 1504'<br>Drlg. 2603' |
| 2/10 | Top 3088', Heeb 3298', Tor 3318',<br>Doug 3329', Lans 3338',<br>DST 3419-32', 1 hr., 30' ocm, 90'<br>ocw, 1200#<br>B KC 3543', Arb. 3580<br>RTD 3583'<br>5" @ 3582' |
| 2/17 | DD 3585 SO DD 3588 S/3 BOPH 2 hrs.<br>DD 3591 TD S/6 BOPH 500 A<br>S/42 BO 1 hr. POP |
| 2/24 | Spud 1-29-54<br>Oil Well<br>TD 3591'<br>8" @ 155'<br>Anhy 1504', Top 3 088', Heeb 3298',<br>Tor 3318', Doug 3329', Lans 3338'<br>DST 3419-32', opn 1 hr., rec.30' ocm,<br>90' ocw, 1200#<br>B KC 3543', Arb. 3580'<br>TD 3583'<br>5" @ 3582'<br>DD 3585', DD 3588', S/3 boph 2 hrs.<br>DD 3591', S/6 boph 500A S/42 boph<br>Comp. 2074 bopd COMPLETED |

DX-78

FORM 275 FOR SALE BY KANSAS BLUE PRINT CO.

County Rooks State Kansas

Sec. 20- (Blk. Twp.) 9 - (Sur. Rge.) 18W Map No.

Operator Heathman & Co.

Well No. 4 Farm Baumgartner "B"

Elev. Location SW NE NE

| | | | | | | | |
|---|---|---|---|---|---|---|---|
| | | | | | | | |
| | | | | | | o | |
| | | | | | | | |
| | | | | | | | |
| | | | | | | | |
| | | | | | | | |
| FIRST REPORT | | | | | | | |
| | | | | | | | |

990 Ft. From N Line NE

990 Ft. From E Line Quarter

1st. Report FEB 3 1954

Completion

Remarks

Spudding Date 1-29-54

Drlg. Data Baumgartner Pool

8" @ 155 Anhy 1504 drlg. 2603

J. G. McGEHEE

FORM 275 FOR SALE BY KANSAS BLUE PRINT CO.

County Rooks State Kansas

Sec. 20 (Blk. Twp.) 9 (Sur. Rge.) 18W Map No.

Operator Heathman & Co.

Well No. 4 Farm Baumgartner "B"

Elev. Location SW NE NE

990 Ft. From N Line NE

990 Ft. From E Line Quarter

1st. Report

Completion FEB 24 1954

Remarks Baumgartner Pool

Spudding Date 1-29-54

COMPLETE

Drlg. Data Oil well TD 3591

8" @ 155 Anhy 1504 Top. 3088

Heeb. 3298 Tor. 3318 Doug. 3329

Lans. 3338 DST 3419-32 open 1 hr.

Rec. 30' ocm 90' ocw 1200# B KC 3543

Arb. 3580 TD 3583 5" @ 3582 DD 3585

DD 3588 S/ 3 boph 2 hr. DD 3591

S/ 6 boph 500 A. S/ 42 boph

Comp. 2074 bopd

J. G. McGEHEE