
Rooks KANSAS

DX 78-1

Section 20 Township 9 Range 18W

Well No. 5 Bumgarton "B"

Company Heathman & Seeligson

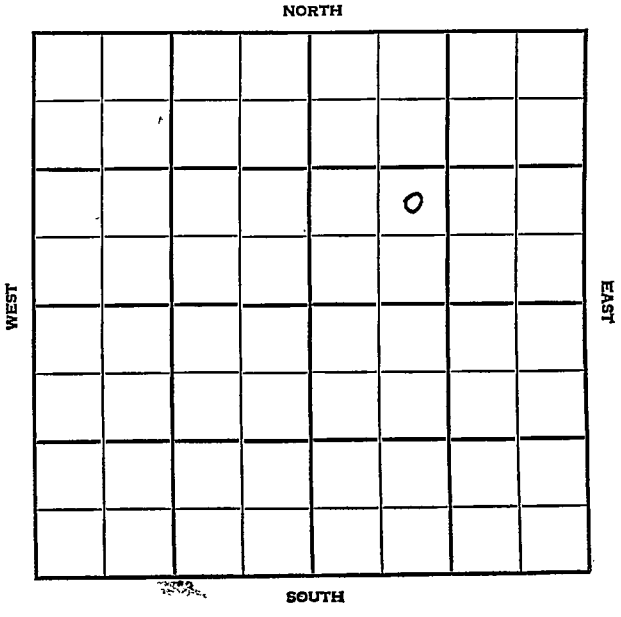

Rooks KANSAS

SEC.	TWP.	R.
20	9	18W

WELL NO. 5 Bumgarton "B"

FARM

COMPANY Heathman & Seeligson

CONTRACTOR


~~Paradise Creek Pool~~

_____ Ft. from N. Line

990 Ft. from S. Line

_____ Ft. from E. Line

990 Ft. from W. Line

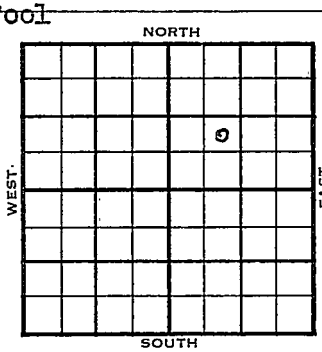

NE SW NE

1954	ELEVATION 2174	REPORT
7/21	Cellar & Pitts	
8-11	Spdg 7-30-54	
	D&A	
	TD 3647	
	8 " @1660	
	Anhy 1504 Heeb 3319 Lans. 3359	
	Arb. 3610	
	DST 3613-20 open 1 hr. Rec. 15' mud	
	0#0#	
	DST 3620-27 open 1 hr. Rec. 22' mud	
	460#	
	TD 3647	
	D&A	
	ABANDONED	

DX-78

FORM 275 FOR SALE BY KANSAS BLUE PRINT CO.


County Rooks State Kansas

Sec. 20 (Blk. / Twp.) 9 (Sur. / Rge.) 18W Map No.

Operator Heathman & Seeligson

Well No. 5 Farm Bumgarten "B"

Elev. Location NE SW NE

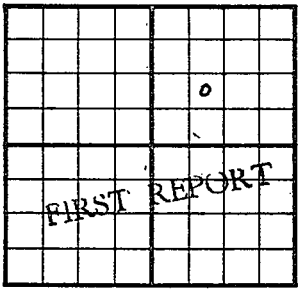

990 Ft. From S Line NE

990 Ft. From W Line Quarter

1st. Report JUL 21 1954

Completion

Remarks

Spudding Date

Drlg. Data Paradise Creek Pool

Cellar & pits

J. G. McGEHEE

FORM 275 FOR SALE BY KANSAS BLUE PRINT CO.


County Rooks State Kansas

Sec. 20 (Blk. Twp.) 9 (Sur. Rge.) 18W Map No.

Operator Heathman & Seeligson

Well No. 5 Farm Bumgarten "B"

Elev. 2174 Location NE SW NE

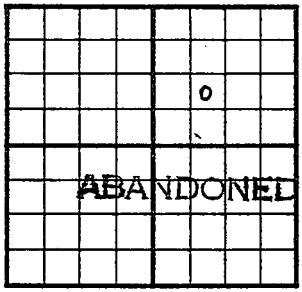

990 Ft. From S Line NE

990 Ft. From W Line Quarter

1st. Report

Completion AUG 11 1954

Remarks Paradise Creek Pool

Spudding Date 7-30-54

Drlg. Data D & A TD 3647

8" @ 160 Anhy 1504 Heeb. 3319

Lans. 3359 Arb. 3610 DST 3613-20

open 1 hr. Rec. 15' mud 0#

DST 3620-27 open 1 hr. Rec. 22' mud

460# TD 3647

D & A

7D