


Map No. KANSAS Sec. 20 Twp. 9 R. 18^W
 Well No. L-Sandberg Farm
Prairie O & G Company

NORTH

WEST

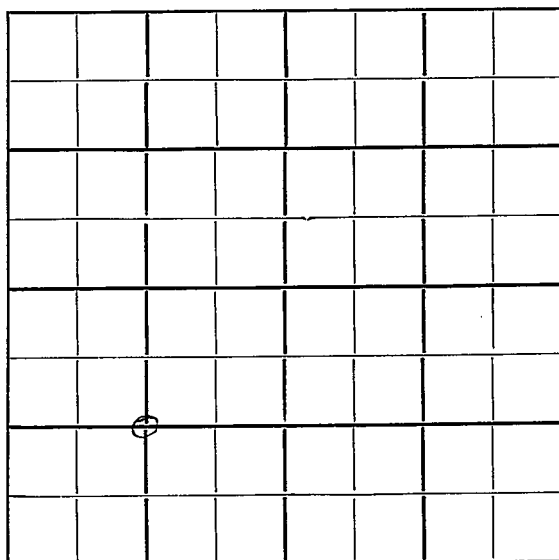

EAST

SOUTH

Location.....

Drilling Remarks

.....

.....

RECORD

Cased..... in..... ft.

Sand.....

Gas.....

Oil.....

Total Depth.....

Rig Up.....

Drilling Remarks

.....

.....

PRODUCTION

1st 24 hrs. Nat.....

1st 24 hrs. after shot.....

Gas..... cu. ft.....

Dry Hole.....

Abandoned.....


Map No. KANSAS Sec. 20 Twp. 9 R. 18^w
 Well No. 1 - Sanbury Farm
Prairie Oil & Gas Company

_____ Ft. from N. Line

1320 Ft. from S. Line

_____ Ft. from E. Line

1320 Ft. from W. Line

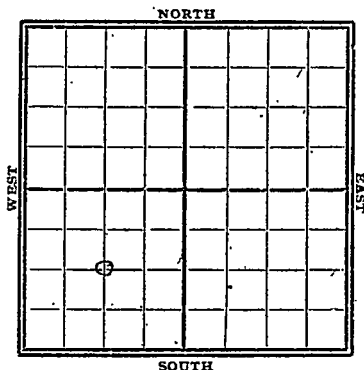

1928

Date	REPORT
11/17	Rol.
11/14	Bldg Rig
11/21	_____
11/28	Rig
12/5	_____
12/12	_____
12/19	Rign up
12/26	_____
1929	
1/2	drlg 715'
1/8	" 880'
1/16	" 985'
1/23	" 1050' 15"-992'
1/30	" 1245'
2/6	" 1275'
2/13	" 1515'
2/20	" 1600'
2/27	" 2105'
3/6	" 2570'
3/13	show oil & H.F.W.-2890.-5D.
3/20	drlg 3105'
3/27	" 3150'

4/3- Only 3175'

4/10 - " 3384 Toward
at 3370'

4/17- Show oil 3440-50
nery 3520'

4/24- Only 3600'

5/1 - S.D. 3600'

5/8- Berham sd 3610

show oil 3615-23

HFW 3665-75

T.D. 3676-S.D.

5/15 —

5/22- nery 3725'

5/29 - fsg tools 3860

6/5- S.D. 3860'

6/12- T.D. 3860'

Dry & Abandoned

Reels
No tracing
 MAP NO. 11111111 SEC. 20 TWP. 9 R. 18W

WELL NO. 1 *Sandberg*

Prairie O & G COMPANY

CONTRACTOR

SECTION PLAT

_____ FT. FROM N. LINE

1320 FT. FROM S. LINE

_____ FT. FROM E. LINE

1320 FT. FROM W. LINE

FIRST REPORTS

LOCATION _____

RIG UP _____

DRILLING AND REMARKS:

ROG

RECORD

CASED _____ IN. _____ FT.

SAND _____

GAS _____

OIL _____

TOTAL DEPTH _____

PRODUCTION

1ST 24 HRS. NAT. _____

1ST 24 HRS. AFTER SHOT _____

GAS _____ CU. FT.

DRY HOLE _____

ABANDONED _____

DATE

NOV 7 1928 192 S. J. LEWIS SCOUT

Map No. **KANSAS** Sec. 20 Twp. 9 R. 18W
 Well No. 1 Sandberg

Prairie Oil & Gas Company
 Contractor


SECTION PLAT

_____ Ft. from N. Line

1320 Ft. from S. Line

_____ Ft. from E. Line

1320 Ft. from W. Line

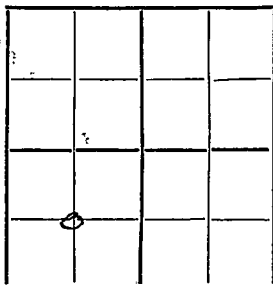

ABANDONED

Location _____

Rig up _____

Drilling and Remarks:

ND

RECORD

Cased _____ in., _____ ft.

Sand _____

Gas _____

Oil _____

Total Depth 3860

PRODUCTION

1st 24 hrs. Nat. _____

1st 24 hrs. after shot _____

Gas _____ Cu. Ft.

Dry Hole _____

Abandoned _____

Date

JUN 12 1929

S. J. LEWIS Scout