

Section 20 Township 9 S Range 19 W

Well No. #1-B Gick

Company Petroleum Ind.

13

NORTH

6							
0							

WEST

EAST

SOUTH

County Rooks Elev. _____
 Sec. 29 Twp. 9S Rgs. 19W
 Company Petroleum Inc.
 FarmName Gick No. 1-B

TOPS	DEPTH	LOG	DATUM	Loc. in Sec.									
Anh.	<u>1528</u>			<u>NW SW SW</u>									
Tp.													
H.				<u>DS-SW/4 SW/4</u>									
Tr.													
Dg.				Geol. _____									
Bl.													
L.				Contr <u>Rig #10</u>									
K.C.													
B.K.C.				Pool _____									
Ce.													
C.				<u>Gick</u>									
M.													
M.				<table border="1"> <tr> <td></td> <td></td> <td></td> </tr> <tr> <td colspan="3" style="text-align: center;">FIRST REPORT</td> </tr> <tr> <td></td> <td></td> <td></td> </tr> </table>				FIRST REPORT					
FIRST REPORT													
K.													
Mz.				<table border="1"> <tr> <td></td> <td></td> <td></td> </tr> <tr> <td colspan="3" style="text-align: center;">JUL 20 '55</td> </tr> <tr> <td></td> <td></td> <td></td> </tr> </table>				JUL 20 '55					
JUL 20 '55													
Me.													
V.													
S.													
S.													
A.													
R.													
Pe.													
G.													
T.D.													

Date Comm. 7/16/55
8th 211 w/145 D 1700

See correction attached

Co.
No.
Sec.
T.
R.

SCOUT TICKET

DX-201

Kansas

SEC.

20

TWP.

9S

R.

19W

WELL NO.

1-B Gick

FARM

COMPANY

Petroleum Inc.

CONTRACTOR

CORRECTION

NW SW SW

NORTH

_____ FT. FROM N. LINE


990

_____ FT. FROM S. LINE

_____ FT. FORM E. LINE

330

_____ FT. FROM W. LINE

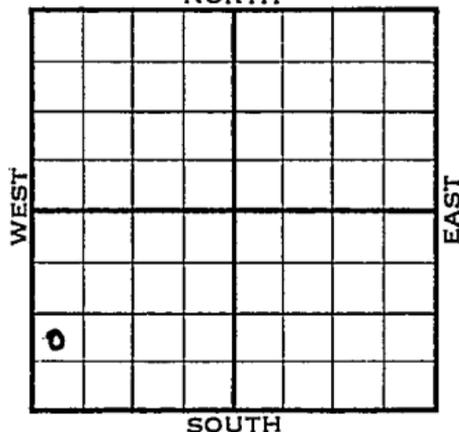

~~Rooks County~~

LOCATION

RIG UP

DRILLING AND REMARKS:

Reported

29-9S-19W

RECORD

CASED IN., FT.

SAND

GAS

OIL

TOTAL DEPTH

1ST 24 HRS. NAT.

1ST 24 HRS. AFTER SHOT

GAS CU. FT.

DRY HOLE

ABANDONED

PRODUCTION

DATE

JUL 27 1955

SCOUT

L. J. Harris

County Rooks Elev. 2135
 Sec. 20 Twp. 9 Rge. 19W
 Company Petroleum Inc.
 Farm Name Gick No. 1-B

TOPS	DEPTH	LOG	DATUM	Loc. in Sec.
Anh.	<u>1528</u>			NW SW SW
Tp.		<u>3086</u>	<u>951</u>	
H.	<u>3293</u>	<u>3292</u>	<u>1157</u>	
Tr.				
Dg.				
BL.				
L.	<u>3336</u>	<u>3337</u>	<u>1202</u>	Geol.
K.C.				Contr.
B.K.C.				
Ce.				
C.				
M.				
M.				Pool
K.				<u>Gick</u>
Mz.				
Ma.				
V.				
S.				
S.				
A.	<u>3595</u>	<u>3595</u>	<u>1460</u>	<div style="border: 1px solid black; padding: 5px; text-align: center;"> ABANDONED 7/27/55 </div>
R.				
PE.				
G.				
TD.	<u>3640</u>			

Date Comm. 7-16-55 JUL 27 1955
8" @ 211/145 DST 3112-22 open 1 hr.
Rec. 95' mw 990/20" DST 3596-3602
open 1 hr. Rec. 15' mud 0/20"
DST 3599-3607 open 1 hr. Rec. 90' mud
0# DST 3581-3612 open 1 hr. Rec.
50' vsocm 10' sw 610/20" TD 3640

D & A