FORM 51 IOM 12-46 PETROL


KANSAS Rooks

Section 20 Township 9 Range 20W

Well No. 1 Neil

Company Palmer Oil

Palco

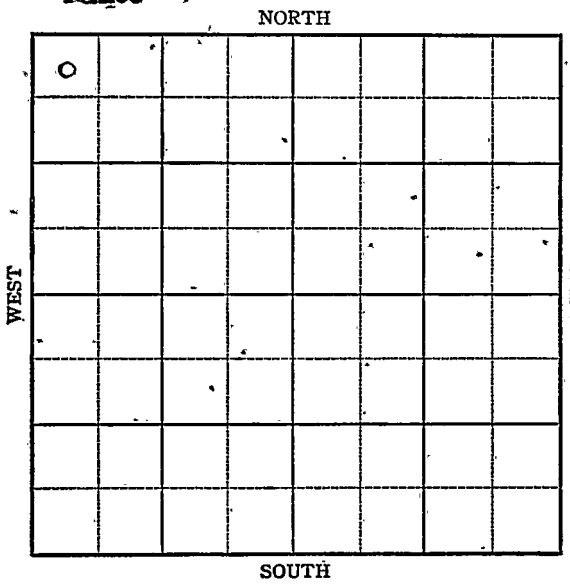


4

FORM 252-A
5M 12-46 PETROL

Rooks KANSAS

Sec. 20 Twp. 9S R. 20W

Well No. 1 Neil Farm

Palmer Oil Company

Ralco Pool


330 Ft. from N. Line

Ft. from S. Line

Ft. from E. Line

330 Ft. from W. Line

NW/C

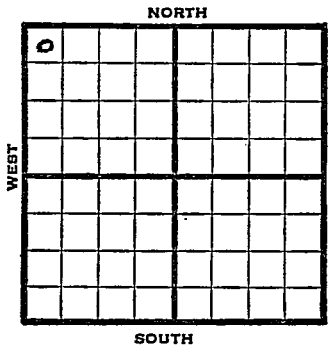


| 1947 | Elev. 2293' REPORT |
|---|---|
| 3/26 | Location |
| 4/2 | 8" @ 187'<br>Drlg 1725' |
| 4/9 | Lans 3569<br>Arb 3860<br>TD 3861'<br>Run csg |
| 4/15 | 5" @ 3861'<br>RUST |
| 4/23 | " " |
| 4/29 | " " |
| 5/7 | " " |
| 5/13 | " " |
| 5/20 | " " |
| 5/27 | TD 3885' HFW |
| 6/4 | Arb. 3860'<br>TD 3887' |
| | ABANDONED |

Form 26 200 Bks. 10-46 Petrol

Palco Pool

Kansas

Map No. K65 Sec. 20 Twp. 9 R. 20W

Well No. 1 Neil

Palmer Oil Company

FIRST REPORT Contractor

NW/C

330 Ft. from N. Line


Ft. from S. Line

Ft. from E. Line

330 Ft. from W. Line

Rooks County

SECTION PLAT

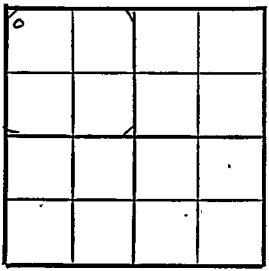

Location X

Rig up

Drilling and Remarks:

RECORD

Cased in., ft.

Sand

Gas

Oil

Total Depth

PRODUCTION

1st 24 hrs. Nat.

1st 24 hrs. after shot

Gas Cu. Ft.

Dry Hole

Abandoned

Date

MAR 2 6 1947 19

S. J. LEWIS Scout

Form 26 200 Bks. 10-46 Petrol

Kansas

Palco Pool

Map No. 65 Sec. 20 Twp. 9 R. 20W

Well No. 1 Neil


Palmer Oil Company

ABANDONED Contractor

NW/C

E. 2289

SECTION PLAT

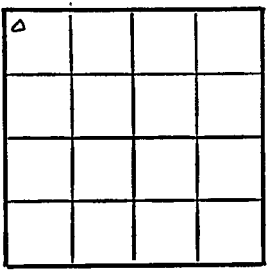

330 Ft. from N. Line

____ Ft. from S. Line

____ Ft. from E. Line

330 Ft. from W. Line

Rooks County

Location

Rig up

Drilling and Remarks:

Cl X 3560

RECORD

Cased ____ in., ____ ft.

Sand

Gas

Oil

Total Depth 3887

PRODUCTION

1st 24 hrs. Nat.

1st 24 hrs. after shot

Gas ____ Cu. Ft.

Dry Hole

Abandoned

Date

JUN 4 1947 19 S. J. LEWIS Scout