


Section 20 Township 9 Range 21W

Well No. #2 Davignon

Company Cities Service

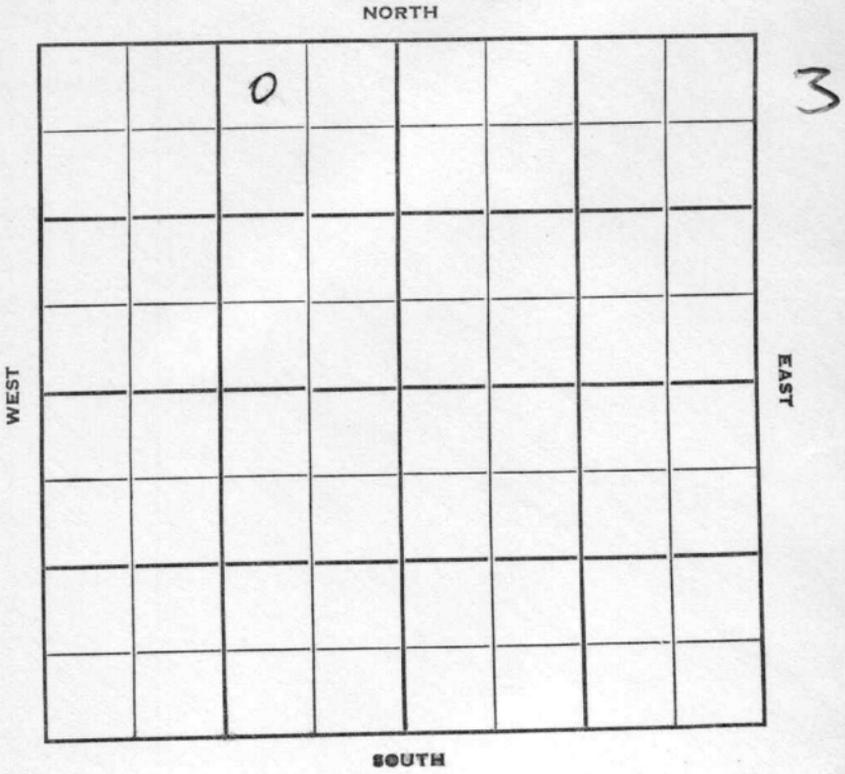

Sec. 20 Twp. 9 R. 21W

Well No. #2 Davignon Farm \_\_\_\_\_

Cities Service Company \_\_\_\_\_

Contractor Morel Pool


300' Ft. from N. Line

\_\_\_\_\_ Ft. from S. Line

900' Ft. from E. Line

\_\_\_\_\_ Ft. from W. Line

NW NE NW

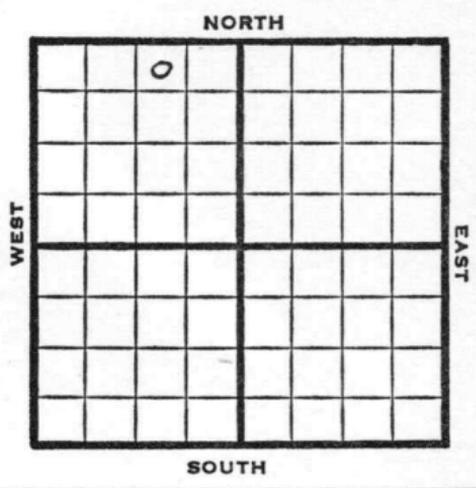

1950 Elev. 2316' REPORT

5/3

Location

5/24

8" @ 279'

Heebner 3474'

Dodge 3495'

Lans. 3515'

Cong. 3793'

Simp. 3803'

Arb. 3834

TD 3838'

5" @ 3833'

Comp. 3000 BOPD

TD 3838'

**COMPLETED**

Kansas

Morel Pool

Map No. \_\_\_\_\_ Sec. 20 Twp. 9 R. 21W

Well No. 2 Davignon

Cities Service Company

Contractor

NW NE NW

E 1. 2316  
SECTION PLAT

330 Ft. from N. Line

\_\_\_\_\_ Ft. from S. Line

990 Ft. from E. Line

\_\_\_\_\_ Ft. from W. Line

	0		

FIRST REPORT

Graham County

Location \_\_\_\_\_

Rig up \_\_\_\_\_

Drilling and Remarks:

RECORD

Cased \_\_\_\_\_ in., \_\_\_\_\_ ft.

Sand \_\_\_\_\_

Gas \_\_\_\_\_

Oil \_\_\_\_\_

Total Depth \_\_\_\_\_

PRODUCTION

1st 24 hrs. Nat. \_\_\_\_\_

1st 24 hrs. after shot \_\_\_\_\_

Gas \_\_\_\_\_ Cu. Ft.

Dry Hole \_\_\_\_\_

Abandoned \_\_\_\_\_

Date

MAY 3 1950 19

J. E. TYRA Scout

Kansas

Map No. \_\_\_\_\_ Sec. 20 Twp. 9 R. 21W

Well No. 2 Davignon

Cities Service Company

Contractor \_\_\_\_\_

NW NE NW

E1.2316  
SECTION PLAT

330 Ft. from N. Line

\_\_\_\_\_ Ft. from S. Line

990 Ft. from E. Line

\_\_\_\_\_ Ft. from W. Line

	0		

Graham

Location \_\_\_\_\_

Rig up \_\_\_\_\_

Drilling and Remarks:

8" c 279  
 Hubner 3474  
 Dodge 3495  
 Sand. 3515  
 Cong. 3793  
 Sings. 3803  
 arb. 3834  
 T.D. 3838  
 5" c 3833

RECORD

Cased \_\_\_\_\_ in., \_\_\_\_\_ ft.  
 Sand \_\_\_\_\_  
 Gas \_\_\_\_\_  
 Oil \_\_\_\_\_  
 Total Depth 3838

PRODUCTION

1st 24 hrs. Nat. \_\_\_\_\_  
 1st 24 hrs. after shot \_\_\_\_\_  
 Gas \_\_\_\_\_ Cu. Ft.  
 Dry Hole \_\_\_\_\_  
 Abandoned \_\_\_\_\_

Cony. 3000 bopd  
Date \_\_\_\_\_

MAY 24 1950 19

J. E. TYRA Scout