


Section 20 Township 9 Range 21W

Well No. #2 Furey "A"

Company C SO

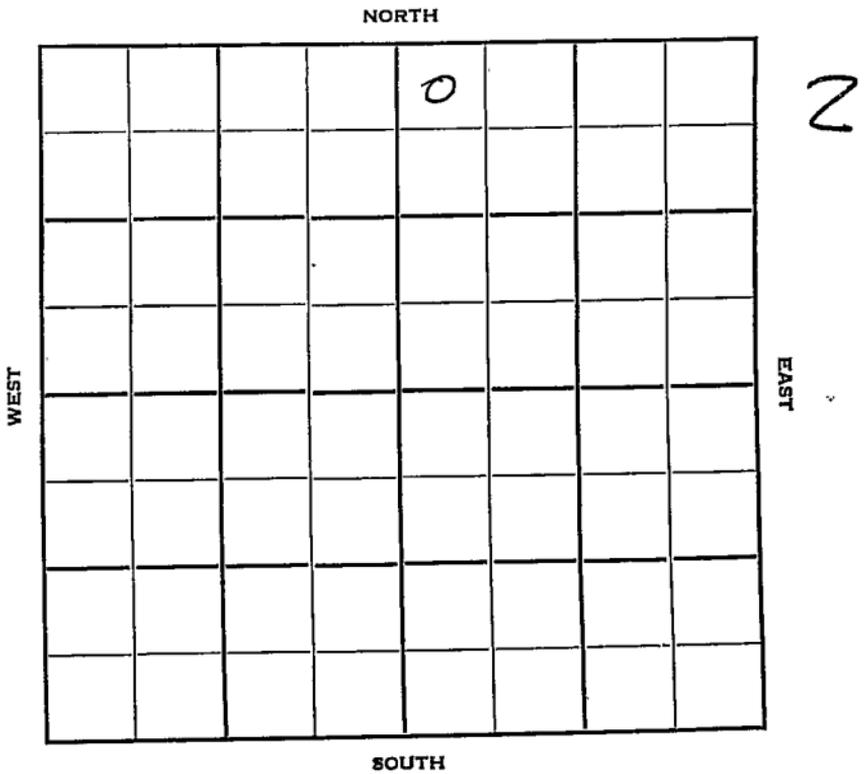

20

9

21W



Sec. _____ Twp. _____ R. _____

Well No. #2 Furey "A" Farm _____

C S O Company _____


Morel Pool Contractor _____

330' Ft. from N. Line

_____ Ft. from S. Line

_____ Ft. from E. Line

330' Ft. from W. Line

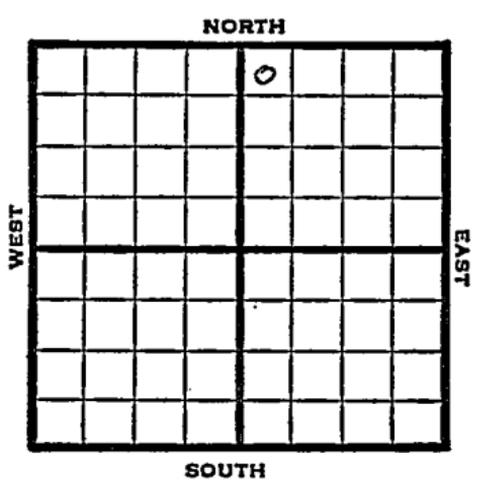

NW NW NE

1950 Elev 2297 REPORT

6/21 Location

7/19 8" @ 240
 Heeb 3460 Lans 3500
 Arb 3803
 TD 3805
 5" @ 3805
 DD 3809
 2800' oil 3 hr
 Pump 480 bopd
 DD 3812
 Comp Echometer Pot. 2770 bopd
 Completed

COMPLETED

Map No. _____ Sec. 20 Twp. 9 R. 21W

Well No. 2 Furey "A"

C S O _____ Company

_____ Contractor

NW NW NE


330 Ft. from N. Line

_____ Ft. from S. Line

_____ Ft. from E. Line

330 Ft. from W. Line

SECTION PLAT

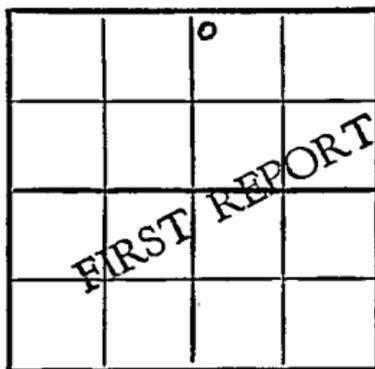

Graham County

Location X

Rig up _____

Drilling and Remarks:

RECORD

Cased _____ in., _____ ft.

Sand _____

Gas _____

Oil _____

Total Depth _____

PRODUCTION

1st 24 hrs. Nat. _____

1st 24 hrs. after shot _____

Gas _____ Cu. Ft.

Dry Hole _____

Abandoned _____

Date

JUN 21 1950 19

J. E. TYRA

Scout

Kansas

Map No. _____ Sec. 20 Twp. 9 R. 21W

Well No. 2 Furey "A"

Cities Service Company

Contractor

NW NW NE

El. 2297
SECTION PLAT

330 Ft. from N. Line

_____ Ft. from S. Line

_____ Ft. from E. Line

330 Ft. from W. Line

COMPLETE

Graham County

Location _____

Rig up _____

Drilling and Remarks:

- 8" @ 240
- Heeb. 3460
- Lans. 3500
- Arb. 3803
- TD 3805
- 5" @ 3805
- DD 3809

RECORD

Cased _____ in., _____ ft.
 Sand _____
 Gas _____
 Oil _____
 Total Depth 3812

PRODUCTION

1st 24 hrs. Nat. _____
 1st 24 hrs. after shot _____
 Gas _____ Cu. Ft.
 Dry Hole _____
 Abandoned _____

Date JUL 19 1950

19

J. E. TYRA Scout

2800' soil + 3 hr.

Pump 480 bodd

DD 3812

Comp Echometer Pot. 2770 bodd

AUG 1 1950

Scout Cards	✓
Land Small Map	✓
Land Wall Map	✓
Tracings	✓
France Map	✓
Pierce Map	✓
Misc.	✓

DD 3812









 





