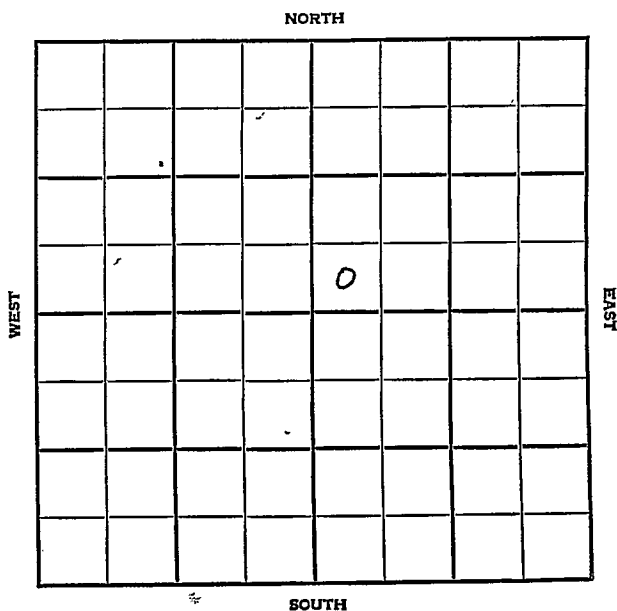


Section 20 Township 9 Range 22 WWell No. #1 Titus H. DenningCompany Stanolind

Graham

KANSAS

SEC. 20	TWP. 9	R. 22W
------------	-----------	-----------

WELL NO.

#1 Titus H. Denning

FARM

COMPANY

Stanolind

CONTRACTOR

Prime

N. Red Line


Ft. from N. Line

Ft. from S. Line

Ft. from E. Line

Ft. from W. Line

SW SW NE

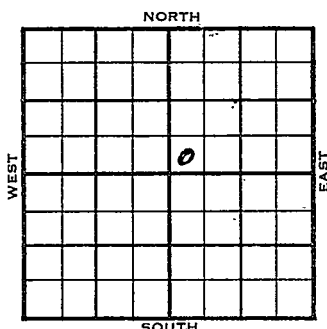SDX - $\frac{1}{2}$ mile

1956	ELEVATION	REPORT
	2395	
3-7	Comm. 2-29-56 8" @ 206/150 Drlg. 3090	
3-15	Heeb. 3611, Tor. 3633 Läns. 3648, BKC 3874, Marm. 3944, DST 3555-95, op 40 min. rec 1628' sw, 1250/20" DST 3676-94, op 1 hr. rec. 60' msw, 900 so&gcs, 640/30" DST 3697-3710, op 1 hr. rec 445' wtr., 1190/30" DST 3727-50, op 1 hr. rec. 545' ocs, 1200# DST 3830-40, op 1 hr. rec. 95' sw, 1160/30" Drlg. 4016'	
3-21	DST 4050-82 op 1 hr. rec 2540' msw, 1180/20" D & A A 4046 4047 TD 4082	

ABANDONED

County Graham Elev. _____
 Sec. 20 Twp. 9 Rge. 22W
 Company Stanolind
 FarmName Titus H. Denning No. 1

TOPS	DEPTH	LOG	DATUM	Loc. in Sec.
Anb.				SW SW NE
Tr.				
H.				
Tr.				
Dg.				
BL.				
L.				
K.C.				Geol. _____
B.K.C.				Contr. _____
Ce.				Prime
C.				
M.				
M.				
K.				Pool
Mz.				N. Red. Line
Mq.				
V.				
S.				
S.				
A.				
R.				
Pf.				
G.				
T.D.				

FIRST REPORT
 MAR 7 1955
 1/2 mile

Date Comm. 2-29-56
8" @ 206/150 drlg. 3090

Handwritten signature/initials

2398

County

Graham

Elev.

2395

Sec.

20

Twp.

9

Rge.

22W

Company

Stanolind

FarmName

Titus H. Denning

No. 7

TOPS	DEPTH	LOG	DATUM
Anb.			
Tr.			
H.	3611	3611	
Tr.	3635	3636	
Dg.			
BL.			
L.	3648	3652	1254
K.C.			
B.K.C.	3874	3871	1473
Ce. Mamm.	3944	3946	1548
C.			
M.			
M.			
K.			
Mz.			
Mq.			
V.			
S.			
S.			
A.	4046	4047	1649
R.			
Pe.			
G.			
TD.	4082		

Loc. in Sec.

SW SW NE

Geol.

Contr.

Prime

Pool

N. Red Line



ABANDONED

Date Comm. 2-29-56

MAR 21 1956

8" @ 206/150 DST 3555-95 open 40 min.

rec. 1628' sw 1250/20" DST 3676-94

open 1 hr. rec. 60' msw 900' so & gcs

640/30" DST 3697-3710 open 1 hr.

rec. 445' wtr. 1190/30" DST 3727-50

open 1 hr. rec. 545' ocs 1200#

DST 3830-40 open 1 hr. rec. 95' sw

1160/30" DST 4050-82 open 1 hr.

rec. 2540' msw 1180/20"

D & A