

Graham

KANSAS

SECTION 20 TOWNSHIP 9S RANGE 22W

WELL NO. #2 Farrell "B"


COMPANY J. F. Darby Oil Co.

NORTH

NW ^{NE} SW

WEST

EAST

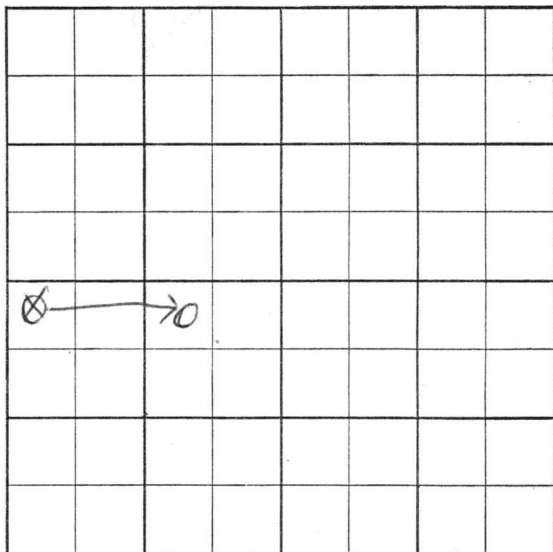

SOUTH

~~Top~~ ~~Pool~~
~~Oil~~ ~~Facet~~

WILDCAT

S-513-B

County Graham Elev. _____
 Sec. 20 Twp. 9 Rge. 22W
 Company J. F. Darby Oil Co;
 Farm Name Farrell "B" No. 2

TOPS	DEPTH	LOG	DATUM
Anh.			
Tp.			
H.			
Tr.			
Dg.			
B. L.			
L.			
K. C.			
B. K. C.			
Ce.			
C.			
M.			
M.			
K.			
Mz.			
Mq.			
V.			
S.			
S.			
A.			
R.			
Pf.			
G.			
T. D.			

Loc. in Sec. _____
NW NW SW
 Geol. _____
 Contr. _____
Iron Drlg.
 Pool _____
Wildcat



Date Comm. _____

MIM

Co.
Lse.
No.
Sec.
T.
R.

Twps. ~~X~~ Pool ~~X~~

CORRECTION Co. ~~X~~ Facet ~~X~~

S-513-B

County Graham Elev 24160F 2419RB
 Sec 20 Twp. 9 Rge. 22W
 Company J. F. Darby Oil Co.
 Farm Name Farrell "B" No. 2

TOPS	DEPTH	LOG	DATUM
Anh.	1951		
Tp.	3400		
H.	3624		
Tr.			
Dg.			
B.L.			
L.	3660		
K.C.			
B.K.C. <u>11 dr m</u>	3907		
Ce.			
C.	3993		
M.			
M.			
K.			
Mz.			
Mq.			
V.			
S.			
S.			
A.	4075		
R.			
Pf.			
G.			
T.D.	4110		

Loc. in Sec. NW NW SW
NE
 Geol.
 Contr.
Iron Drlg.
 Pool Wildcat
ABANDONED
 JUN 18 '58

Date Comm. 6-1-58
 MIN JUN 3 '58 ~~Ø~~ JUN 11 '58 8" 203/160 DST
 3655-80 1 1/2 hrs 150' wtry m 5069c
 BHP 700 DST 3682-3705 1 1/2 hrs 210
 gem 50 240 HOCW 75% wtr ~~420~~ 660
 W ~~240~~ BHP 925/22" FPO-525
 DST 3840-61 1hr 25' m BHP 1000 DST
 PST 3826-68 1hr 30' m BHP 1000 DST
 4030-57 1hr 30' m S50 BHP 225 Ø 4057
 JUN 18 '58 no log DBA

Co.
 Use.
 No.
 Sec.
 T.