


Section 20 Township 9 Range 22 W

Well No. #1 Ferrell

Company J. F. Darby

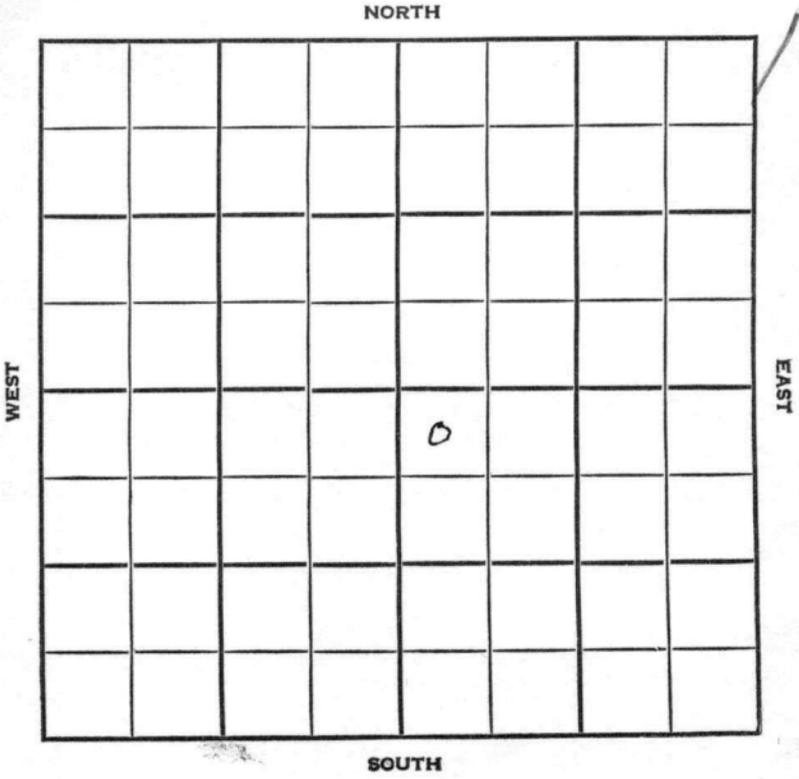

SEC.	TWP.	R.
20	9	22W

WELL NO.

#1 Ferrell

FARM

COMPANY

J. F. Darby

CONTRACTOR

IRON


WILDCAT

\_\_\_\_\_ Ft. from N. Line

\_\_\_\_\_ Ft. from S. Line

\_\_\_\_\_ Ft. from E. Line

\_\_\_\_\_ Ft. from W. Line

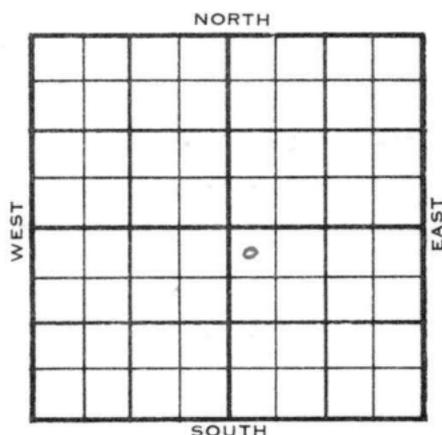

NW NW SE

Stanolind - DHM

 $\frac{1}{2}$  mile SDX

	ELEVATION	REPORT
1955	2391 KB	
9/21	Comm 9/15/55 8" @ 200 w/150 Anh 1937 D 3070	
9-29	<del>##</del> ; Heeb. 3606; Lsg. 3641; DST 3296-3344 op 1 hr. rec. 225' wtr. BHP 1015# DST 3634-60 op 1 hr. rec. 7' mud, 0# 15"; DST 3668-90 op $1\frac{1}{4}$ hr. rec. 960' gas 140' ocm, 860' oil, 120' wtr., 1130#20"; DST 3708-40 op $1\frac{1}{4}$ hr. rec. 1220' smcsw 1125#; DST 3764-3810 op 1 hr. rec. 10' mud, BHP 0#; DST 3826-61 op 1 hr. rec. 20' mud, BHP 840# 20"	
10-6	5 $\frac{1}{2}$ " @ 3950, WOC	
10-13	CO 16/ 3819-23, 1000 A, S/ 2 bfph(40% oil) 25/ 3676-80, S/ 2 boph, 1000 A, S/ 21 bo 1 hr., FU 1150' from surface in 12 hrs., S/ 5 bfph, 30% wtr. S/168.2 bf, 30% wtr., 12 hrs., POP	

10-20 No report

10-27 P/ 45 bopd, 58% wtr.

11-3 No report

11-10 P/ 7 $\frac{1}{4}$  bo 24 hrs.

P/ 52 bo 24 hrs.

P/41 $\frac{1}{2}$  bo 24 hrs.

11-16 Comp. 50 bopd, 49% wtr

T.D. 4098'

<u>Tops</u>	<u>Depth</u>	<u>Log</u>
Tr.		3626
B.K.C.	3868	3866
Marm	3885	
Marm Ch.		3937
A.		4066

COMPLETED

County Graham Elev. 2391 KB  
 Sec. 20 Twp. 9 Rge. 22W  
 Company J. F. Darby  
 Farm Name Ferrell No. 1

TOPS	DEPTH	LOG	DATUM
Anh.	1937		
Tp.			
H.			
Tr.			
Dg.			
B.L.			
L.			
K.C.			
B.K.C.			
Ce.			
C.			
M.			
M.			
K.			
Mz.			
Me.			
V.			
S.			
S.			
A			
R.			
PE.			
G.			
T.D.			

Loc. in Sec. NW NW SE  
Stano - DHM  
 Geol. Hap Prior  
 Contr.  
Iron  
 Pool



Date Comm. 9/15/55 8" 200 w/150 D 3070

*[Handwritten signature]*

Co.  
 Lse.  
 No.  
 Sec.  
 T.  
 R.

County Graham Elev. 2391 KB  
2389 DF  
 Sec. 20 Twp. 9 Rge. 22W  
 Company J. F. Darby  
 FarmName Perrell No. 1

TOPS	DEPTH	LOG	DATUM	Loc. in Sec.
Anh.	<u>1937</u>			NW NW SE
TP.				
H.	<u>3606</u>	<u>3604</u>	<u>1213</u>	
Tr.		<u>3626</u>	<u>1235</u>	
Dg.				
BL.				
L.	<u>3641</u>	<u>3640</u>	<u>1249</u>	Geol.
K.C.				
B.K.C.	<u>3868</u>	<u>3866</u>	<u>1475</u>	Contr.
Ce. <u>Mamm</u>	<u>3885</u>		<u>1494</u>	Iron Drlg.
C. <u>Mammch.</u>		<u>3937</u>	<u>1546</u>	
M.				Pool
M.				Wildcat
K.				
Mz.				
Me.				
V.				
S.				
S.				
A.		<u>4066</u>	<u>1675</u>	COMPLETE
R.				
PE.				
G.				
T.D.	<u>4098</u>			

Date Comm. 9-15-55 NOV 16 1955

8" @. 200/150 DST 3296-3344 open 1 hr.  
 rec. 225' wtr. 1015# DST 3634-60  
 open 1 hr. rec. 7' mud 0/15"  
 DST 3668-90 open 1 1/4 hr. rec. 960' gas  
 140' ocm 860' oil 120' wtr. 1130/20"  
 DST 3708-40 open 1 1/4 hr. rec. 1220'  
 smcsw 1125# DST 3764-3810 open 1 hr.  
 rec. 10' mud - 0# DST 3826-61 open 1 hr

Rec. 20' mud 840/20" 5 $\frac{1}{2}$ " @ 3950  
CO 16/ 3819-23 1000 A S/ 2 bfph  
40% oil 25/ 3676-80 S/ 2 boph  
1000 A S/ 21 bo 1 hr. . FU 1150' from  
surface in 12 hr. S/ 5 bfph. 30% wtr.  
S/ 168.2 bf 30% wtr. 12 hr.  
P/ 45 bopd 58% wtr. P/ 74 bo 24 hr.  
P/ 52 bo 24 hr. P/ 41 $\frac{1}{2}$  bo 24 hr.  
Comp. 50 bopd 49% wtr.

Scout Cards *R. B.*  
Land Small Map  
Land Wall Map  
Tracings  
France Map  
Pierce Map  
Misc.

NOV 25 1955