

Section 20 Township 9 Range 23 WWell No. # 1 RobinsonCompany Peel-Hardman

NORTH

○							

SOUTH

WEST

EAST

4

Graham KANSAS

Sec. 20 Twp. 9 R. 23 W

Well No. # 1 Robinson Farm

Peel-Hardman Company

Contractor

Wildcat

330 Ft. from N. Line


Ft. from S. Line

Ft. from E. Line

330 Ft. from W. Line

NW NW NW

Globe & Mag. - DHM

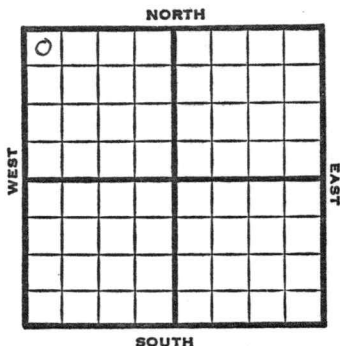

1951

Elev. 2399' REPORT

4/25

Location

5/16

Spud 4-27-51

D & A TD 4368'

8" @ 174 Anhy 2020' Top 3490'

Heeb 3708' Lans. 3748' B KC 3987'

Cong 4257' Arb. 4318'

TD 4368' D & A

ABANDONED

County Graham State KansasSec. 20 (Blk.) 9 (Sur. Rge.) 23W Map No.Operator Peel - HardmanWell No. 1 Farm RobinsonElev. Location NW NW NW

0							
FIRST REPORT							

330 Ft. From N Line NW330 Ft. From W Line Quarter1st. Report APR 25 1951

Completion

Remarks Globe & Mag. - DHM

Spudding Date

Drlg. Data WildcatLocation

J. E. TYRA

County Graham State KansasSec. 20 (Blk.
Twp.) 9 (Sur.
Rge.) 23W Map No.Operator Peel - HardmanWell No. 1 Farm RobinsonElev. 2399 Location NW NW NW

0							

330 Ft. From N Line NW330 Ft. From W Line Quarter

1st. Report

Completion MAY 16 1951Remarks WildcatSpudding Date 4-27-51Drlg. Data D & A TD 43688" @ 174 Anhy 2020 Top. 3490Heeb. 3708 Lans. 3748 B KC 3987Cong. 4257 Arb. 4318 TD 4368D & A

J. E. TYRA