

Graham


KANSAS

SECTION 20 TOWNSHIP 9S RANGE 24W

WELL NO. #1 Mitchell

COMPANY Burch Drlg.

NORTH SE SE SW

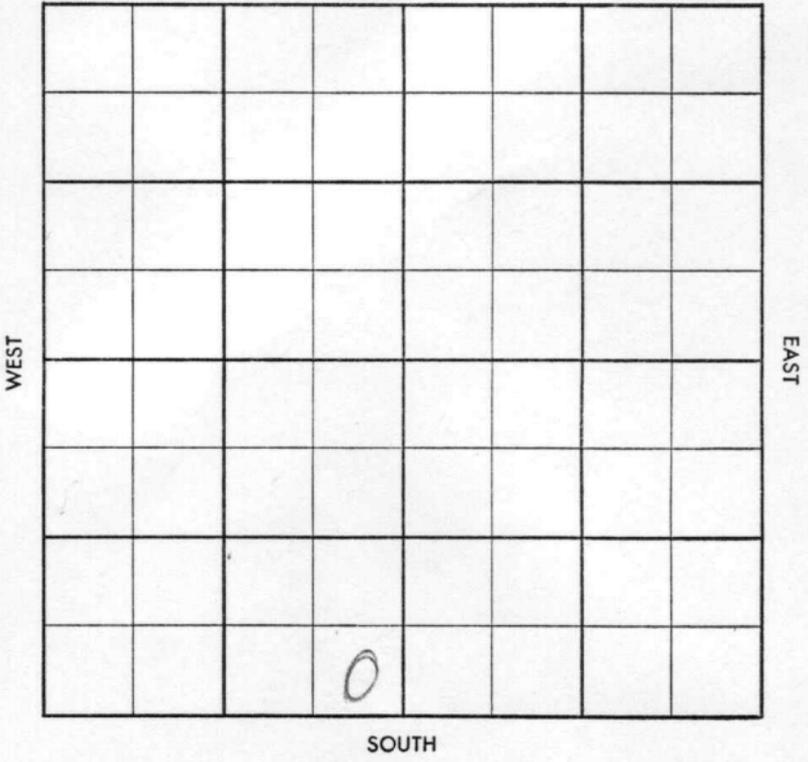



Twp. ~~\_\_\_\_\_~~ Pool ~~\_\_\_\_\_~~  
 Co. ~~\_\_\_\_\_~~ Facet ~~\_\_\_\_\_~~

5-513.B

County Graham Elev. 2528 KB  
 Sec. 20 Twp. 9 Rge. 24W 2525 BF  
 Company Burch Drlg.  
 Farm Name Mitchell No. 1

TOPS	DEPTH	LOG	DATUM	Loc. in Sec.
Anth.				SE SE SW
Tp.				
H.	38 33			
Tr.	38 53			
Dg.				
B.L.				
L.	3671			
K.C.				Geol.
B.K.C.				Confr.
Ce.				Co. Tools #1
C.				
M.				Pool Mitchell
M.				Wildcat
K.				
Mz.				
Mq.				
V.				
S.				
S.				
A.				
R.				
Pf.				
G.				
T.D.	4115			COMPLETE

Date Comm. 2/2/58  
 8" @ 220, Drlg. 1000 FEB 12 58 DST 386A-90  
 60" 1340' SW BHP 1050 DST 3895  
 3922 60" 395' SW BHP 1220 DST  
 3937-60 60" 220' SW BHP 1320  
 4002-45 60" 60' WCM BHP  
 1190 DST 4042-65 FEB 19 58 60"  
 85' OCM 10' HGCM 1' freeoil  
 BHP 510 DST 4065-86 60"  
 40' M BHP 0 log 5" 4114/150

Co.  
Lse  
No.  
Sec.  
T.  
R

LD 12/4053-56 51/2 hrs

FU 159 F SCUM oil FEB 26 '58

\$ 13.78 BF 15' low 4 hrs

2 1/2 FU 350' FID

\$ 6 B FPH 1090 W NT

\$ 2 1/3 B FPH 1590 W 10 hrs

POP MAR 5 '58 MAR 12 '58 MAR 19 '58 MAR 26 '58

APR 2 '58 APR 9 '58 APR 16 '58 APR 23 '58 APR 30 '58

MAY 7 '58 MAY 14 '58 MAY 21 '58 MAY 28 '58 JUN 3 '58 P

HyP 3130 pd NW JUN 11 '58 JUN 18 '58

JUN 25 '58 JUL 2 '58 92 38°

Lsg 4053-56

20-9-24W se se sw