


Graham KANSAS

SECTION 20 TOWNSHIP 9 S RANGE 24 W

WELL NO. # 2 Wittman

COMPANY Imperial

NORTH C SE NW

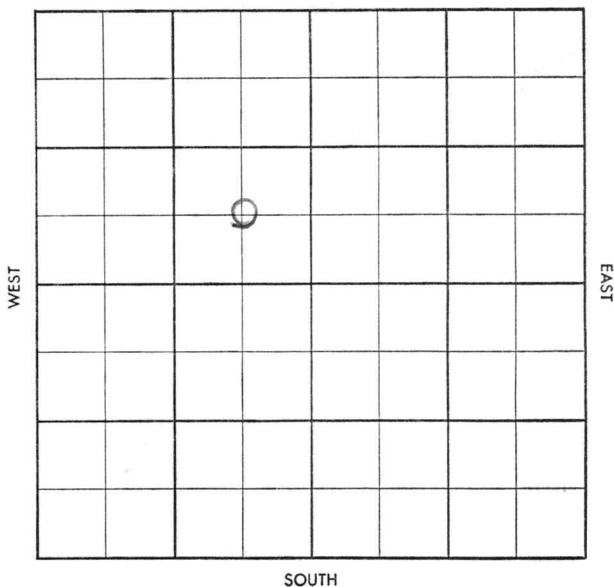

Top NO Post 6
Bottom Post 6

Co.	Lse.	No.	Sec.	T.	R.
-----	------	-----	------	----	----

Twp. Pool

Co. Facet

S-513-B

County Graham Elev. 2537 RB
 Sec. 20 Twp. 9S Rge. 24W 3534D
 Company Imperial
 Farm Name Wittman No. 2

TOPS	DEPTH	LOG	DATUM	Loc. in Sec.
Anh.	<u>2190</u>			<u>C SE NW</u>
Tp.				
H.	<u>3831</u>			
Tr.	<u>3856</u>			
Dg.				
B.L.				
L.	<u>3869</u>			
K.C.				Geol.
B.K.C.				Contr <u>Co Tools</u>
Ce.				<u>Rig #2</u>
C.				
M.				
M.				Pool
K.				<u>Mitchell</u>
Mz.				
Mq.				
V.				
S.				
S.				
A.				
R.				
Pf.				
G.				
T.D.	<u>4192</u>			

ABANDONED

Date Comm. MIRT 9-8-58
SEP 17 '58 8" 231/150 DST 3892-3912
60" 5'M BHP 30 DST 3909-32 60"
5'M Press zero DST 3995-4025
60" 10'M Press 0 DST 4022-40

SEP 24 '58 1 Hr. Rec 12'm Press 0
DIT 4038-62 1 Hr. 30'm BHP 30

DFA