

State Geological Survey
WICHITA, BRANCH

RECEIVED
STATE CORPORATION COMMISSION

JAN 8 1973


KANSAS CORPORATION COMMISSION

CONSERVATION DIVISION
Wichita, Kansas

WELL RECORD

(Mail to Kansas Geological Survey, 4150 Monroe Street, Wichita, Kansas 67209)

10-9-21W
E/2 E/2 SE

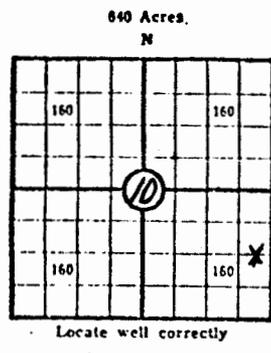

API # 15-065-20,578

Lease Name: J. F. Loveridge Well No. 5
 Well Located: 1320' FSL & 330' FEL
SEC 10 TWP 9S RGE 21W
 Operator: Continental Oil Company
 Address: 3535 N. W. 58th Street, Oklahoma City, Oklahoma
 Elevation: Ground 2226' D.F. K.B. 2231'
 Type Well: (Oil, gas, dry hole) Oil

Drilling Commenced: December 9, 19 72 Drilling Completed: Dec. 18, 1972
 Well Completed: January 2 19 73 Total Depth 3770'
 Initial Production: 304 BO & No Water

Casing Record

Size: 8-5/8" Set at 268' Size: Set at
 Size: 5-1/2" Set at 3768' Size: Set at

Liner Record

Size: None Set from To

Cementing

Casing Size	Sacks	Type Cement and Additives
<u>8-5/8"</u>	<u>200</u>	<u>Class H, 2% Gel and 2% Cacl.</u>
<u>5-1/2"</u>	<u>200</u>	<u>High density Class A, 10% salt and 3/4% CFR-2</u>

Perforations

Formation	Perforated Interval and Number Shots
<u>Penn Conglomerate</u>	<u>3702-14' and 3717-19'</u>
<u> </u>	<u> </u>
<u> </u>	<u> </u>

Electric Log Run (Show type log and depths covered)

Radiation Guard, Acoustic Velocity, Temperature Survey.

(Fill in formation and related information on reverse side)

FORMATION, TESTING AND COMPLETION RECORD

Show Drill Stem Tests,
Well Stimulation and
Production Tests

Formation	Top	Bottom	
	See Attached.		



CONSERVATION DIVISION
BNA
1978