


KANSAS GEOLOGICAL SOCIETY
KANSAS WELL LOG BUREAU - KANSAS WELL SAMPLE BUREAU
 KANSAS GEOLOGICAL SOCIETY BUILDING
 508 EAST MURDOCK - WICHITA, KANSAS

COMPANY **DANE G. HANSEN ESTATE**
 FARM **Eichman** NO. **8**

SEC. **12** T. **9** R. **21W**
 LOC. **NE SW SE**

TOTAL DEPTH **3690'**
 COMM. **4-18-67** COMP. **4-27-67**
 SHOT OR TREATED
 CONTRACTOR **C-G Drlg.**
 ISSUED **6-3-67**

COUNTY **Graham**
KANSAS

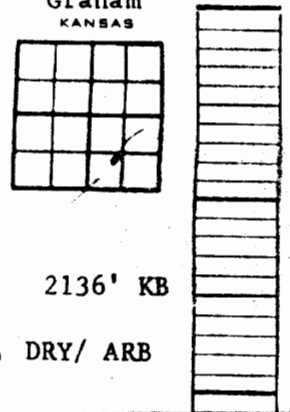

CASING

20	10	
15	8	5/8" 178' cem w/ 130 sx
12	6	
13	5	

ELEVATION **2136' KB**

PRODUCTION **DRY/ ARB**

FIGURES INDICATE BOTTOM OF FORMATIONS

178	1120	SHALE	1/4°	500'
1120	1350	SAND	3/4°	1000'
1350	1400	SHALE	1°	1500'
1400	1629	RED BED SHALE	1-3/4°	2000'
1629	1672	ANHYDRITE	1-3/4°	2165'
1672	1750	RED BED & SHALE	1-1/2°	2280'
1750	2225	SHALE & SHELLS	2°	2460
2225	3470	LIME & SHALE	1-1/4°	2555'
3550	3670	LIME	1-1/2°	2710'
3675	3690	ARBUCKLE		

DST #1 3442-3470'
 DST #2 3667-3670'
 MISSOURI DST #3 3667-3675'
 DST #4 3642-3681'

TOPS: SMP

Anhydrite	1629
Heebner	3340
Toronto	3363
Lansing	3381
Base Kansas City	3596
Arbuckle	3666

STATE OF KANSAS)
 COUNTY OF SEDGWICK) SS:

The undersigned hereby certifies that to the best of his knowledge and belief, the above facts are true and correct.

C-G DRILLING CO.

By G. F. Galloway

G. F. GALLOWAY

SUBSCRIBED AND SWORN TO, BEFORE ME, This 2nd day of MAY, 1967