


Section 21 Township 9 Range \_\_\_\_\_

Well No. #6 Bessey

Company Cities Service

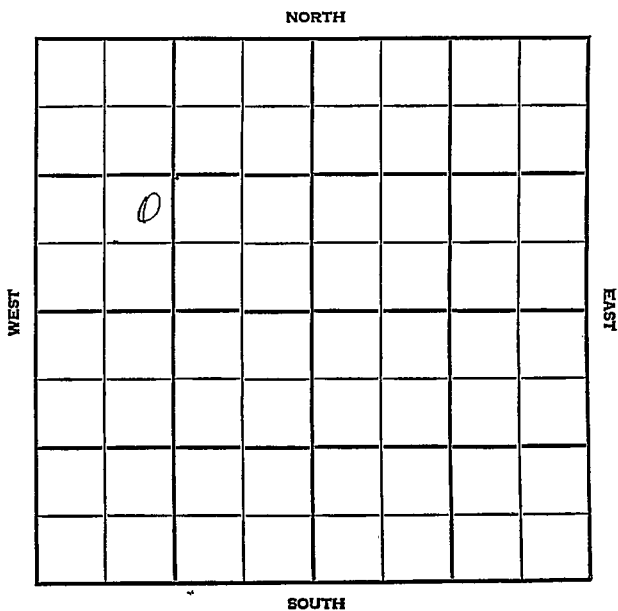

County Rooks Elev. \_\_\_\_\_  
 Sec. 21 Twp. 9 Rge. 16W  
 Company Cities Service  
 FarmName Bessey No. 6

TOPS	DEPTH	LOG	DATUM
Anb.			
TP.			
H.			
Tr.			
Dg.			
BL.			
L.			
K.C.			
B.K.C.			
Ce.			
C.			
M.			
M.			
K.			
Mz.			
Ma.			
V.			
S.			
S.			
A.			
R.			
PE.			
G.			
T.D.			

Loc. in Sec. NE SW NW  
 Geol. \_\_\_\_\_  
 Contr. Braden  
 Pool Dorr  
 NOV 7 1986  
 FIRST REPORT

Date Comm. 11-2-86  
8" @ 240/175 drlg. 2060

NOV 1986

NOV 1986

Co.  
 Sec.  
 No.  
 Sec.  
 T.  
 R.

County Rooks Elev. 2015  
 Sec. 21 Twp. 9 Rge. 16W  
 Company Cities Service  
 FarmName Bessey No. 6

TOPS	DEPTH	LOG	DATUM	Loc. in Sec.
Anh.				NE SW NW
TP.		2879		
H.		3101		
Tr.				
Dg.				
Bl.				
L.		3144		Geol.
K.C.				Contr.
BKC.		3400		Braden
Ce.				Pool
C.				Dorr
M.				
M.				
K.				
Mz.				
Mq.				
V.				
S.				
S.				
A.				
R.				
PE.				COMPLETE NOV 29 '56
G.				
T.D.	3415			

Date Comm. 11-2-86

8" @ 210/175 drlg. 2060 NOV 13 '56

DST 3227-57 1hr 90' SOEGCM

BHP 250/30 1 NOV 21 '56 5 1/2

@ 3414 co 3406 368/3112-3391

tst 10 Goph + 5 Gwph No

P. 412 Bopd + 73 Bwpd.

Co.  
No.  
Sec.  
T.  
R.