

# KANSAS

Rooks

Section 21 Township 9 Range 18W

Well No. 1 Stahl

Company Heathman & Honaker

Paradise

NORTH

	0						

WEST

EAST

SOUTH

Sec. 21 Twp. 9 R. 18W

Well No. #1 Stahl Farm

Heathman & Honaker Company

Company

**Paradise Pool**


NORTH

330' Ft. from N. Line

\_\_\_\_\_ Ft. from S. Line

\_\_\_\_\_ Ft. from E. Line

330' Ft. from W. Line

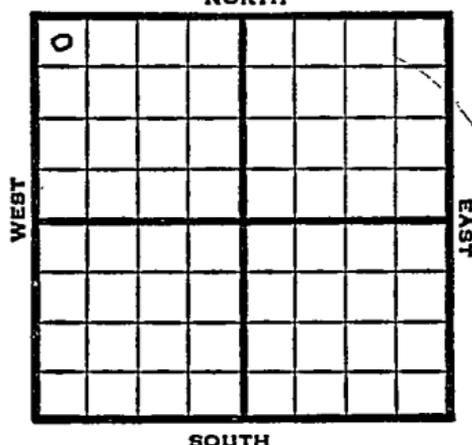

NW/C

1949 Elev 2169' REPORT

4/27 8" @ 158'  
 Anhy 1508'  
 Drlg, 1991'

5/4 Arb. 3587-90'  
 TD 3590'  
 5" @ 3589'

5/10 TD 3595'  
 500 acid  
 swb 1 bbl oil PH

5/18 TD 3599  
 2000 acid  
 Swb 6 bbls oil / 60 W in 5 hrs.

5/25 TD 3599'  
 Arb. 3583'  
 5" @ 3585'  
 Aband.  
**ABANDONED**

Map No. \_\_\_\_\_ Sec. 21 Twp. 9 R. 18W

Well No. 1 Stahl

Heathman & Honaker Company

**FIRST REPORT** Contractor

NW/C

**SECTION PLAT**

330 Ft. from N. Line

\_\_\_\_\_ Ft. from S. Line

\_\_\_\_\_ Ft. from E. Line

330 Ft. from W. Line

o			

Rooks County

Location \_\_\_\_\_

Rig up \_\_\_\_\_

Drilling and Remarks:

8" @ 158

Anhy 1508.

drlg. 1991

**RECORD**

Cased \_\_\_\_\_ in., \_\_\_\_\_ ft.

Sand \_\_\_\_\_

Gas \_\_\_\_\_

Oil \_\_\_\_\_

Total Depth \_\_\_\_\_

**PRODUCTION**

1st 24 hrs. Nat. \_\_\_\_\_

1st 24 hrs. after shot \_\_\_\_\_

Gas \_\_\_\_\_ Cu. Ft.

Dry Hole \_\_\_\_\_

Abandoned \_\_\_\_\_

Date

APR 27 1949 19

S. J. LEWIS Scout

Kansas

Map No. K64 Sec. 21 Twp. 9 R. 18WWell No. 1 StahlHeathman & Honaker Company**ABANDONED**

Contractor

NW/C

E1.2167**SECTION PLAT**330

Ft. from N. Line

Ft. from S. Line

Ft. from E. Line

330 Ft. from W. Line

0			

Rooks County

Location \_\_\_\_\_

Rig up \_\_\_\_\_

Drilling and Remarks:

CR 35835" CR 3585**RECORD**

Cased \_\_\_\_\_ in., \_\_\_\_\_ ft.

Sand \_\_\_\_\_

Gas \_\_\_\_\_

Oil \_\_\_\_\_

Total Depth 3599**PRODUCTION**

1st 24 hrs. Nat. \_\_\_\_\_

1st 24 hrs. after shot \_\_\_\_\_

Gas \_\_\_\_\_ Cu. Ft.

Dry Hole \_\_\_\_\_

Abandoned \_\_\_\_\_

Date

MAY 25 1949 19S. J. LEWIS

Scout