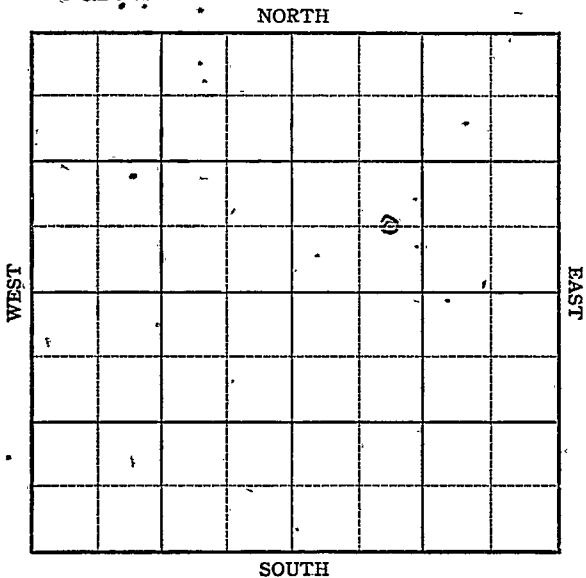


KANSAS

Section 21 Township 9 Range 18-WWell No. #2 HilgersCompany Cities Service
Paradise

KANSAS

Rooks county

Sec. 21 Twp. 9 R. 18W

Well No. 2 Hilgers Farm

Cities Service Company

Paradise Pool

Ft. from N. Line

660


Ft. from S. Line

Ft. from E. Line

990

Ft. from W. Line

C E L SW NE

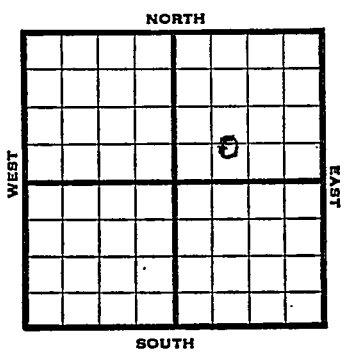

1947 Elev. 2169' REPORT

6/25 Derrick
7/1 Drlg 1485'
7/8 Drlg 3548'
7-16 Lansing 3311
Arbuckle 3567
5" @ 3569
TD 3579
2450' oil in 8 hrs.

7/23 Arbuckle 3567'
5" @ 3569'
1500 Acid
Echo Pot. 3000
Gr. 27
T.D. 3579'
Complete

COMPLETED

Map No. _____ Sec. 21 Twp. 9 R. 18W

Well No. 2 Hilgers

_____ Cities Service _____ Company

_____ **FIRST REPORT** _____ Contractor

C E L SW NE

SECTION PLAT

_____ Ft. from N. Line

660 Ft. from S. Line

_____ Ft. from E. Line

990 Ft. from W. Line

		0	

Rooks County

Location _____

Rig up _____

Drilling and Remarks:

Derrick

RECORD

Cased _____ in. _____ ft.

Sand _____

Gas _____

Oil _____

Total Depth _____

PRODUCTION

1st 24 hrs. Net _____

1st 24 hrs. after shot _____

Gas _____ Cu. Ft.

Dry Hole _____

Abandoned _____

Date

JUN 2 5 1947

19

S. J. LEWIS

Scout

Map No. 64 Sec. 21 Twp. 9 R. 18W

Well No. 2 Hilgers

Cities Service Company

COMPLETE Contractor

C E L SW NE

E12169
SECTION PLAT

 Ft. from N. Line

660 Ft. from S. Line

 Ft. from E. Line

990 Ft. from W. Line

Rooks County

Location

Rig up

Drilling and Remarks:

Per 48567
5' 10" 2568
15000000
Ech 10 283000
27-68

RECORD

Cased in. ft.

Sand

Gas

Oil

Total Depth 3579

PRODUCTION

1st 24 hrs. Nat.

1st 24 hrs. after shot

Gas Cu. Ft.

Dry Hole

Abandoned

Date

JUL 23 1947 19 S. J. LEWIS Scout