

KANSAS


FORM 51 IOM 12-46 PETROL

Rooks county

Section 21 Township 9 Range 18-W

Well No. #1, Rempe

Company W. L. Hartman

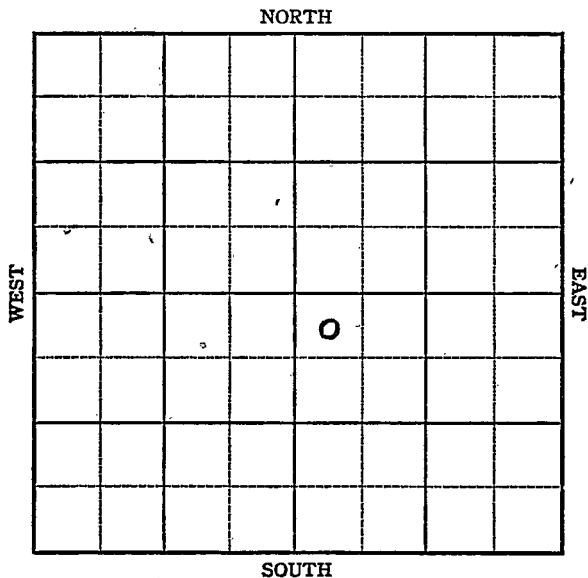

KANSAS


Rooks County

Sec. 21 Twp. 9 R. 18-WWell No. #1 Rempe FarmW. L. Hartman Company

Wildcat

330' Ft. from N. Line Ft. from S. Line Ft. from E. Line330' Ft. from W. Line

NW SE

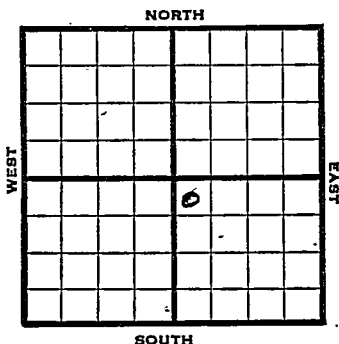

1947

Elev. 2166

REPORT

1/15

12" @ 169'
drlg. 180'

1/21

Anhy 1495
Drlg 3257'

1/30

Topeka 3076'
Arb 3576' -78 TD
70' TD
5" @ 3577'
RUST

2/5

TD 3592
365' oil in 9 hrs

2/12

1000 Acid

2/12

Shot 16 bbls oil Ph
8 hrs

2/19

" " "

2/26

" " "

3/4

TD 3591'

3/12

TD 3591'

3/18

Pump 284 bbls oil in 24 hrs

OVER

3/25	Pump 284 bbls oil 24 hrs	.
4/2	" " "	"
4/9	" " "	"
4/16	" " "	"
4/23	Arb 3576	
	5" @ 3577'	
	1000 Acid	
	Echo Pot 1470'	
	Grav. 25.5	
	TD 3591'	

COMPLETED

Map No. 64 Sec. 21 Twp. 9 R. 18W

Well No. 1 Rempes

W. L. Hartman Company

FIRST REPORT Contractor

NW SE


SECTION PLAT

330 Ft. from N. Line

 Ft. from S. Line

 Ft. from E. Line

330 Ft. from W. Line

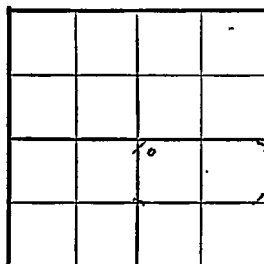

Rooks County

Location

Rig up

Drilling and Remarks:

12" @ 169

drlg. 180

RECORD

Cased in., ft.

Sand

Gas

Oil

Total Depth

PRODUCTION

1st 24 hrs. Nat.

1st 24 hrs. after shot

Gas Cu. Ft.

Dry Hole

Abandoned

Date

JAN 15 1947 19 S. J. LEWIS Scout

KANSAS

Paradise Creek

Kansas

Map No. X64 Sec. 21 Twp. 9 R. 18WWell No. 1 RempeW. L. Hartman Company


COMPLETE

Contractor

NW SE

E1266

SECTION PLAT

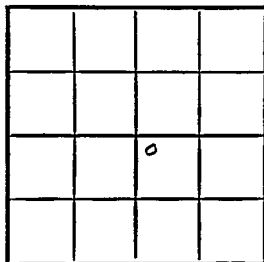330 Ft. from N. Line Ft. from S. Line Ft. from E. Line330 Ft. from W. Line

Rooks County

Location Rig up

Drilling and Remarks:

Ar 83576
5" @ 3577
1000 acud
Ech 83576 1470

25-5/8

RECORD

Cased in., ft.Sand Gas Oil Total Depth 3591

PRODUCTION

1st 24 hrs. Nat. 1st 24 hrs. after shot Gas Cu. Ft.Dry Hole Abandoned

Date

APR 23 1947 19

S. J. LEWIS

Scout