


Section 21 Township 9 Range 18 W

Well No. #1 Stahl

Company B. A. Vonfeldt

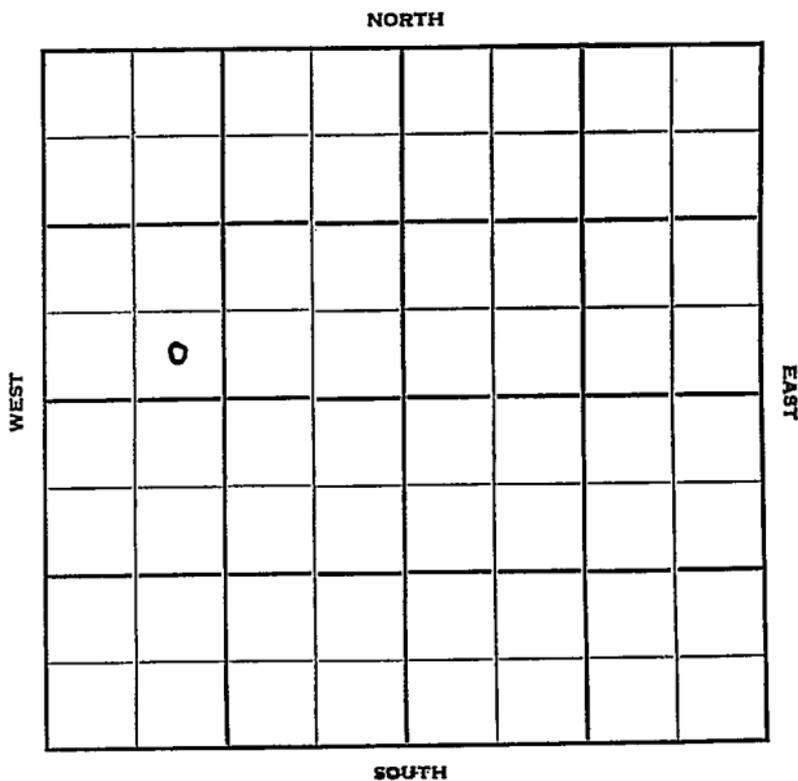

Rooks

KANSAS 18W ✓

Sec. 21 Twp. 9 R. 18W

Well No. #1 Stahl Farm

B.A. Vonfeldt Company

Paradise Creek Contractor


Ft. from N. Line

330' Ft. from S. Line

Ft. from E. Line

990' Ft. from W. Line

SE SW NW

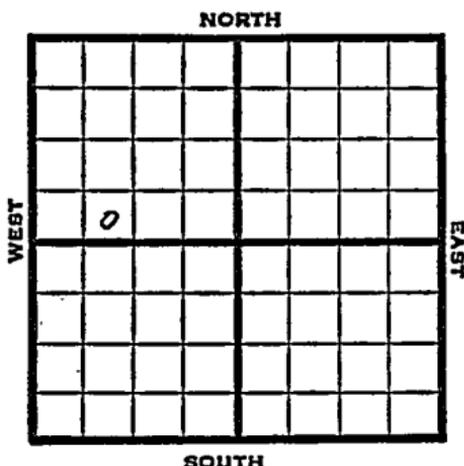

1951 Elev. 2170' REPORT

1/31 Drlg.

2/21 Spud 1-25-51

D & A TD 3603  
 Heeb. 3306 Lans 3345 Arb. 3587  
 DST 3587-94 open  $\frac{1}{2}$  hr. rec. 5' mud  
 TD 3603 D & A

**ABANDONED**



