


Section 21 Township 9 Range 18WWell No. 1 WibmanCompany W. L. Hartman

KANSAS

Rooks

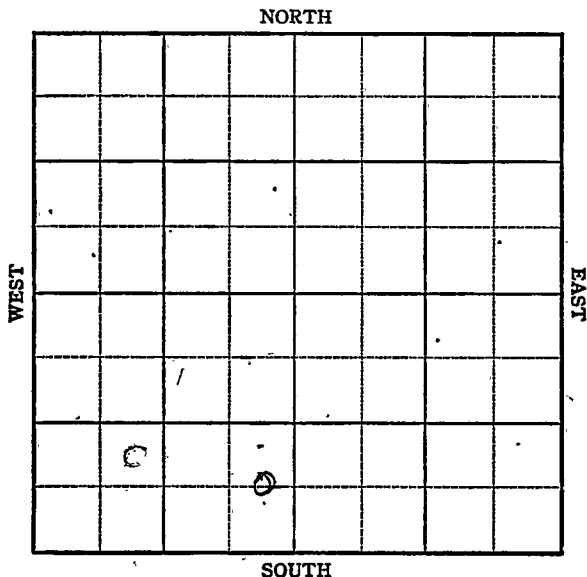

Sec. 21 Twp. 9 R. 18-W

Well No. #1 Wibman Farm

W. L. Hartman Company


Paradise

         Ft. from N. Line

660 Ft. from S. Line

330 Ft. from E. Line

         Ft. from W. Line

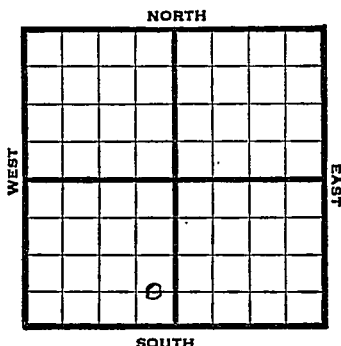

C E L S E S W

1947 <sup>2168</sup> Elev ~~2168~~ REPORT

5/14 Location

5/20 8" @ 164'  
Drlg 2425'

5/27 Lansing 3330'  
Arbuckle 3576'  
TD 3577'  
5" @ 3575'  
RUST

6/3 " "

6/10 TD 3581-2635' fluid

6/21 " " " "


6/25 TD 3581  
Arbuckle 3576'  
5" @ 3575'  
Depth Pot. 3000  
27° Gr.  
Completed

COMPLETED

Kansas Paradise

Map No. R64 Sec. 21 Twp. 9 R. 18WWell No. 1 WibmanW. L. Hartman Company**FIRST REPORT**C E L SE SW Contractor

## SECTION PLAT

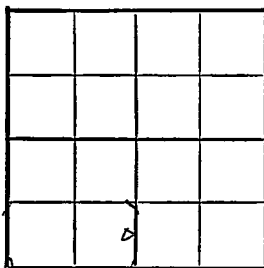         Ft. from N. Line660 Ft. from S. Line330 Ft. from E. Line         Ft. from W. LineRooks CountyLocation XRig up         

Drilling and Remarks:

## RECORD

Cased          in.,          ft.Sand         Gas         Oil         Total Depth         

## PRODUCTION

1st 24 hrs. Nat.         1st 24 hrs. after shot         Gas          Cu. Ft.Dry Hole         Abandoned         

Date

MAY 14 1947 19 S. J. LEWIS Scout

Map No. 64 Sec. 21 Twp. 9 R. 18W

Well No. 1 Wibman

W. L. Hartman Company

**COMPLETE**

Contractor

C E L S E S W

*E/ 2/68*

**SECTION PLAT**

|  |  |  |  |
|--|--|--|--|
|  |  |  |  |
|  |  |  |  |
|  |  |  |  |
|  |  |  |  |

         Ft. from N. Line

660 Ft. from S. Line

330 Ft. from E. Line

         Ft. from W. Line

Rooks County

Location         

Rig up         

Drilling and Remarks:

*Cell 43576*

*5" @ 3575*

*Depth to 2000*

*27° SW*

**RECORD**

Cased          in.,          ft.

Sand         

Gas         

Oil         

Total Depth 2581

**PRODUCTION**

1st 24 hrs. Nat.         

1st 24 hrs. after shot         

Gas          Cu. Ft.

Dry Hole         

Abandoned         

Date

JUN 25 1947 19

S. J. LEWIS

Scout