

KANSAS Rooks

Section 21 Township 9 Range 19W

Well No. 1 Mongeau

Company Peel & Hartman

Wildcat

NORTH

WEST	0						EAST

SOUTH

KANSAS

Rooks

Sec. 21 Twp. 9 R. 19W ✓

Well No. #1 Mongeau Farm

Peel & Hartman Company

Wildcat


330' Ft. from N. Line

_____ Ft. from S. Line

_____ Ft. from E. Line

330' Ft. from W. Line

NW SW

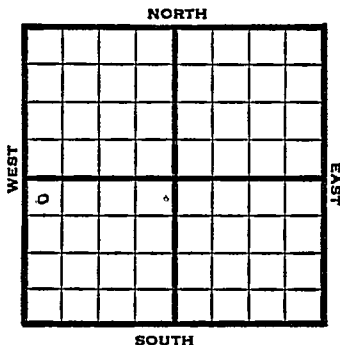

1949

Elev 2121'
2119'

REPORT

3/16

RUR

3/23

8" @ 397'
Drig. 2465'

3/30

Lansing 3325'
Arb. 3631'
Drig 3638'

4/6

TD 3661-
5" @ 3660'
Plug 3490'
12 shots 3482-86'
12 shots 3464-68
1000 acid

4/13

TD 3661'
Arb. 3631'
5" @ 3660'
Aband.

ABANDONED

Map No. _____ Sec. 21 Twp. 9 R. 19W

Well No. 1 Mongeau

Peel & Hartman Company

FIRST REPORT Contractor

NW SW

SECTION PLAT

330 Ft. from N. Line

Ft. from S. Line

Ft. from E. Line

330 Ft. from W. Line

Robks County

RECORD

Location _____

Cased _____ in. _____ ft.

Rig up _____

Sand _____

Drilling and Remarks:

Gas _____

Oil _____

R U R

Total Depth _____

PRODUCTION

1st 24 hrs. Nat. _____

1st 24 hrs. after shot _____

Gas _____ Cu. Ft.

Dry Hole _____

Abandoned _____

Date

MAR 16 1949

19

S. J. LEWIS

Scout

Kansas

Map No. 65 Sec. 21 Twp. 9 R. 19WWell No. 1 MongeauPeel & Hartman Company**ABANDONED**

Contractor

NW SW

E 12121
SECTION PLAT330 Ft. from N. Line Ft. from S. Line Ft. from E. Line330 Ft. from W. Line

0			

Rooks County

Location _____

Rig up _____

Drilling and Remarks:

*Per # 3631**5" @ 3660*

RECORD

Cased _____ in., _____ ft.

Sand _____

Gas _____

Oil _____

Total Depth 3661

PRODUCTION

1st 24 hrs. Nat. _____

1st 24 hrs. after shot _____

Gas _____ Cu. Ft.

Dry Hole _____

Abandoned _____

Date

APR 13 1949 19S. J. LEWIS Scout