

Sec. 21 Twp. 9 R. 20W ✓

Well No. #1 Fesler Farm

Mid-States Oil Company

Contractor


Ft. from N. Line

330' Ft. from S. Line

330' Ft. from E. Line

Ft. from W. Line

SE SE SE

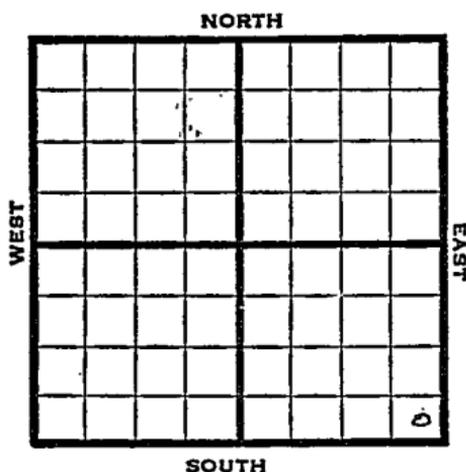

1950	Elev. 2244' REPORT
3/15	Spud 3-10-50 8-5/8" @ 295'
3/29	Drlg. 1755' TD 3812' 8 5/8" @ 295' Heeb 3493' Lans 3534' BKC 3756' Cong 3801-12' D&A Aband.
ABANDONED	

Map No. _____ Sec. 21 Twp. 9 R. 20W

Well No. 1 Fesler

Mid-States Oil

Company

Contractor

SE SE SE

El. 2244
SECTION PLAT

_____ Ft. from N. Line

330 Ft. from S. Line

330 Ft. from E. Line

_____ Ft. from W. Line



Rooks County

Location _____

Rig up _____

Drilling and Remarks:

Spud 3-10-50

8 5/8" @ 295

drlg. 1755

RECORD

Cased _____ in., _____ ft.

Sand _____

Gas _____

Oil _____

Total Depth _____

PRODUCTION

1st 24 hrs. Nat. _____

1st 24 hrs. after shot _____

Gas _____ Cu. Ft.

Dry Hole _____

Abandoned _____

Date

MAR 15 1950

J. E. TYRA Scout

Kansas

Map No. _____ Sec. 21 Twp. 9 R. 20WWell No. 1 FeslerMid-States Oil Company

Contractor

SE SE SE

E1. 2244
SECTION PLAT

_____ Ft. from N. Line

330 Ft. from S. Line330 Ft. from E. Line

_____ Ft. from W. Line



Rooks County

Location _____

Rig up _____

Drilling and Remarks:

8 5/8 @ 295
Hub 3493
Lane 3534
BKC 3756
cong 3801-12
DVA

RECORD

Cased _____ in., _____ ft.

Sand _____

Gas _____

Oil _____

Total Depth 3812

PRODUCTION

1st 24 hrs. Nat. _____

1st 24 hrs. after shot _____

Gas _____ Cu. Ft.

Dry Hole _____

Abandoned _____

Date

MAR 29 1950

19

J. E. TYRA

Scout