

KANSAS


Graham

FORM 51 IOM 12-46 PETROL

Section 21 Township 9 Range 21W

Well No. 1 Anderson "B"

Company Barnett et al
Morel

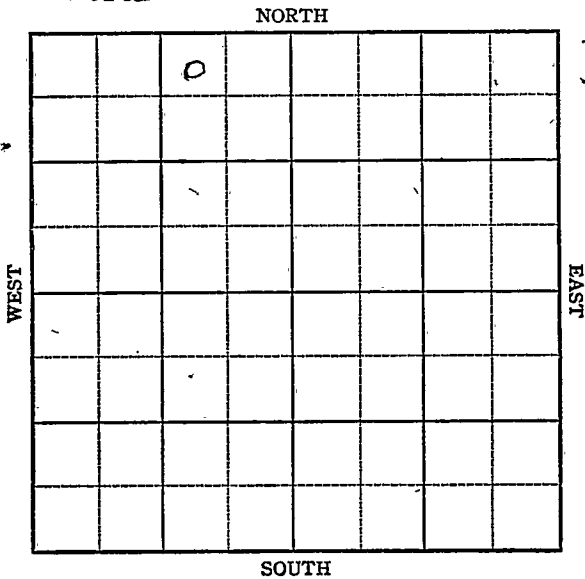

3

KANSAS Graham ✓

Sec. 21 Twp. 9 R. 21W

Well No. #1 Anderson "B" Farm

Barnett et al. Company

Morel


330 Ft. from N. Line

 Ft. from S. Line

990 Ft. from E. Line

 Ft. from W. Line

NW NE NW

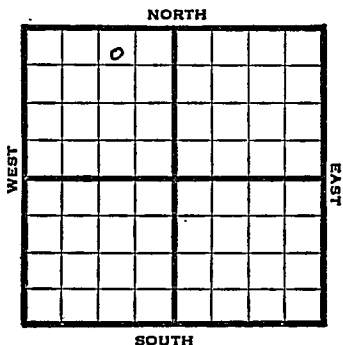

1947

2244

REPORT

4/2

8" @ 195'
Drlg. 630'.

4/9

Drlg 3155'

4/16

Lansing 3439'
Arbuckle 3741'
TD 3743'
5" @ 3742'
RUST

4/23

TD 3746'
2700' oil in 4 hrs
500 acid

4/30

Arb 3741'
5" @ 3742
500 Acid
Depth Pot 3000
Grav. 27.5
TD 3746'

COMPLETED

Map No. 1565 Sec. 21 Twp. 9 R. 21W

Well No. 1 Anderson "B"

Barnett et al.

Company

FIRST REPORT

Contractor

NW NE NW


330 Ft. from N. Line

_____ Ft. from S. Line

990 Ft. from E. Line

_____ Ft. from W. Line

SECTION PLAT

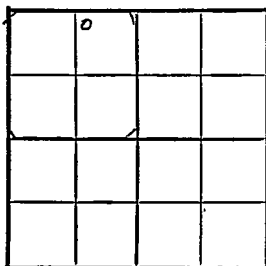

Graham County

Location _____

Rig up _____

Drilling and Remarks:

8" @ 195

drlg. 630

RECORD

Cased _____ in., _____ ft.

Sand _____

Gas _____

Oil _____

Total Depth _____

PRODUCTION

1st 24 hrs. Nat. _____

1st 24 hrs. after shot _____

Gas _____ Cu. Ft.

Dry Hole _____

Abandoned _____

Date

APR 2 1947 19

S. J. LEWIS Scout

Kansas

Map No. 65 Sec. 21 Twp. 9 R. 21WWell No. 1 Anderson "B"Barnett et al. Company**COMPLETE**

Contractor

NW NE NW

E1,2244
SECTION PLAT330 Ft. from N. Line Ft. from S. Line990 Ft. from E. Line Ft. from W. Line

	0		

Graham CountyLocation Rig up

Drilling and Remarks:

Corr 3741
5' to 3742
500 acid
Depth to 2000

*275 lb***RECORD**Cased in., ft.Sand Gas Oil Total Depth 3746**PRODUCTION**1st 24 hrs. Nat. 1st 24 hrs. after shot Gas Cu. Ft.Dry Hole Abandoned

Date

APR 30 1947

19

S. J. LEWIS

Scout