

KANSAS


FORM 51 5M 6-46 PETROL

Graham

Section 21 Township 9 Range 21W

Well No. 1 Feltes

Company A.D. Barnett etal

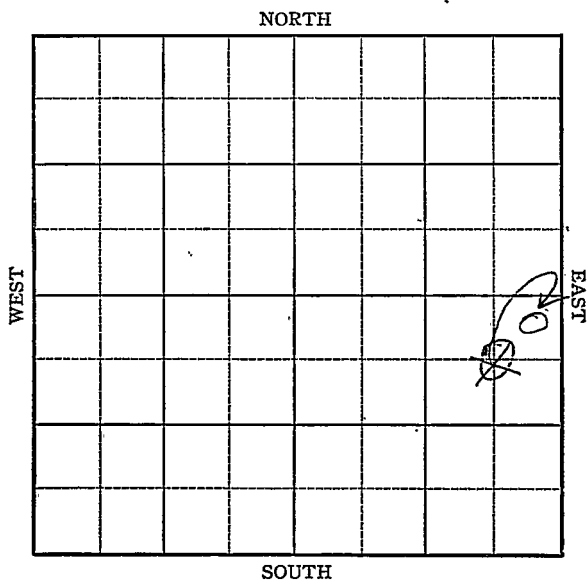


Sec. 21 Twp. 9 R. 21WWell No. #1 Feltes FarmA. D. Barnett et al Company

Morel

660 330 Ft. from N. Line Ft. from S. Line660 330 Ft. from E. Line Ft. from W. Line

NE SE

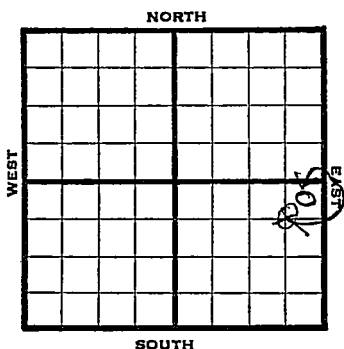

1946

2241

REPORT

7/3

Location

7/9

RUR

7/16

10" @ 166
Anhy 1705
Drlg 2715'

7/23

Lans 3455'
Arb 3777'
TD 3781
5" @ 3777'
RUST

7/30

TD 3781'
2400' oil

8/6

"

8/13

"

8/20

"

8/27

"

9/5

Arb 3777
5" @ 3777
TD 3787
Pump 208 POT
G raw. 28

COMPLETED

KANSAS

Kansas Pool Name MorelMap No. 65 Sec. 21 Twp. 9 R. 21WWell No. 1 FeltresA. D. Barnett et al. Company

FIRST REPORT

Contractor

C NE SE

SECTION PLAT

660 Ft. from N. Line Ft. from S. Line660 Ft. from E. Line Ft. from W. Line

			o

Graham CountyLocation XRig up

Drilling and Remarks:

RECORD

Cased in., ft.Sand Gas Oil Total Depth

PRODUCTION

1st 24 hrs. Nat. 1st 24 hrs. after shot Gas Cu. Ft.Dry Hole Abandoned

Date

JUL 3 1946 19S. J. LEWIS

Scout

KANSAS Kansas Pool Name Morel
 Map No. 60 Sec. 21 Twp. 9 R. 21W

Well No. 1 Feltos

A. D. Barnett et al. Company

CORRECTION

Contractor

NE SE

SECTION PLAT

			60

330 Ft. from N. Line

 Ft. from S. Line

330 Ft. from E. Line

 Ft. from W. Line

Graham County

Location

Rig up

Drilling and Remarks:

Reported C NE SE

RECORD

Cased in., ft.

Sand

Gas

Oil

Total Depth

PRODUCTION

1st 24 hrs. Nat.

1st 24 hrs. after shot

Gas Cu. Ft.

Dry Hole

Abandoned

Date

JUL 10 1946 19

S. J. LEWIS Scout

Pool Name Morel
KANSAS Kansas
 Map No. 21 Sec. 21 Twp. 9 R. 21W

Well No. 1 Feltes

A. D. Barnett et al.

Company

COMPLETED

Contractor

NE SE

E/224/

SECTION PLAT

330 Ft. from N. Line

Ft. from S. Line

330 Ft. from E. Line

Ft. from W. Line

			6

Graham County

Location

Rig up

Drilling and Remarks:

28 8777

5" 8777

Pump 208 804

28 8777

RECORD

Cased _____ in. _____ ft.

Sand

Gas

Oil

Total Depth 8787

PRODUCTION

1st 24 hrs. Nat.

1st 24 hrs. after shot

Gas

Cu. Ft.

Dry Hole

Abandoned

Date

SEP 5 1946 19

S. J. LEWIS

Scout