

KANSAS

Section 21 Township 9^E Range 21WWell No. #3 Andreson "B"Company Barnett Drlg. etal

	o							

NORTH

WEST

EAST

4

SOUTH

KANSAS

Graham



Sec. 21 Twp. 9 R. 21W

Well No. #3 Anderson "B" Farm

Barnett Drlg. et al Company

Morel Pool


330' Ft. from N. Line

_____ Ft. from S. Line

_____ Ft. from E. Line

990' Ft. from W. Line

NE NW NW

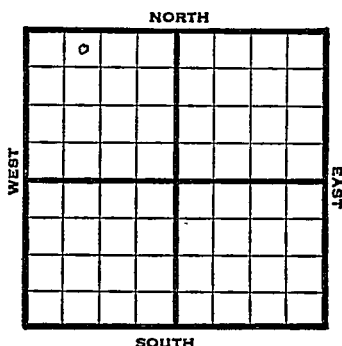

1948

Elev. 2268' REPORT

5/19

Anhy. 1735'

8" @ 146'

Drlg. 2300'

5/26

Lansing 3420'

BKC 3687'

Drlg. 3720'

6/1

Arbuckle 3770'

TD 3778'

5" @ 3771'

1700' oil 1 hr - 400 acid

6/9

Arb. 3770'

5" @ 3771'

400 acid

Echo Pot 2156 oil

Gr. 2718

TD 3778'

Comp.

COMPLETED

Map No. _____ Sec. 21 Twp. 9 R. 21W

Well No. 3 Andreson "B"

Barnett Drlg. etal. Company

FIRST REPORT

Contractor

NE NW NW

SECTION PLAT

330 Ft. from N. Line

_____ Ft. from S. Line

_____ Ft. from E. Line

990 Ft. from W. Line

0			

Graham County

Location _____

Rig up _____

Drilling and Remarks:

* Anhy 1735

8" @ 146

drlg. 2300

RECORD

Cased _____ in., _____ ft.

Sand _____

Gas _____

Oil _____

Total Depth _____

PRODUCTION

1st 24 hrs. Nat. _____

1st 24 hrs. after shot _____

Gas _____ Cu. Ft.

Dry Hole _____

Abandoned _____

Date

MAY 19 1948

19

S. J. LEWIS

Scout

Map No. 65 Sec. 21 Twp. 9 R. 21W

Well No. 3 Andreson "B"

Barnett Drlg. etal. Company

COMPLETE

Contractor

NE NW NW

E 12268
SECTION PLAT

330 Ft. from N. Line

 Ft. from S. Line

 Ft. from E. Line

990 Ft. from W. Line

0			

Graham County

Location

Rig up

Drilling and Remarks:

Cor & 3770

5" @ 3771

400 @ 3771

Echd Pot & 2156

27 1/2 ft

RECORD

Cased in., ft.

Sand

Gas

Oil ✓

Total Depth 3775

PRODUCTION

1st 24 hrs. Nat.

1st 24 hrs. after shot

Gas Cu. Ft.

Dry Hole

Abandoned

Date

JUN 9 1948 19 S. J. LEWIS Scout