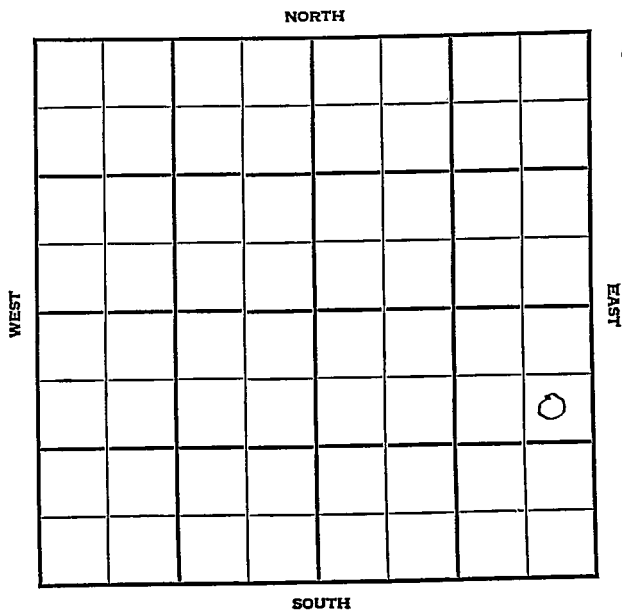


Section 21 Township 9 Range 21WWell No. 2 FeltCompany Barnett Drlg.

KANSAS

Graham

Sec. 21 Twp. 9 R. 21W

Well No. #2 Felt Farm

Barnett Drlg. Company

Morel Pool


990' Ft. from N. Line

Ft. from S. Line

330' Ft. from E. Line

Ft. from W. Line

SE NE SE

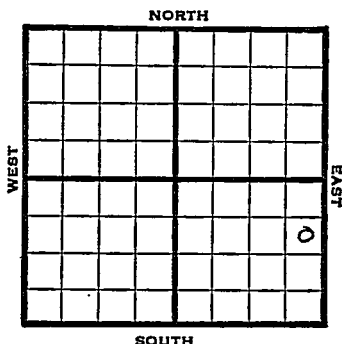

1948

Elev. 2262' REPORT

7/28

RUR

8/4

8" @ 128'

Drlg. 3120'

8/11

Lans. 3478'

BKC 3703'

Congl 3803'

TD 3821'

ABANDONED

Graham County Kansas State

Map No. _____ Sec. **21** Twp. **9** R. **21W**

Well No. 2 Felt

Barnett Drlg. Company

FIRST REPORT

Contractor

SE NE SE

SECTION PLAT


990 Ft. from N. Line

Ft. from S. Line

330 Ft. from E. Line

_____ Ft. from W. Line

Morel Pool

Remarks:

R U R

Date
JUL 28 1948

Scout S. J. LEWIS

