

KANSAS

FORM 51 5M 10-41 PETROL


Graham

Section 21 Township 9 Range 21-W

Well No. #1 Kirkpatrick

Company Barnett & R. W. Shields

Wildcat

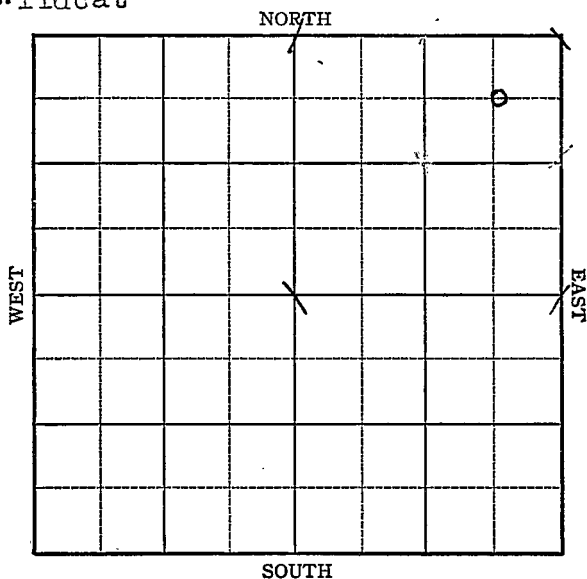

KANSAS

Sec. 21 Twp. 9 R. 21-W

Well No. #1 Kirkpatrick Farm

Barnett & R. W. Shields Company


Wildcat

660 Ft. from N. Line

 Ft. from S. Line

560 Ft. from E. Line

 Ft. from W. Line

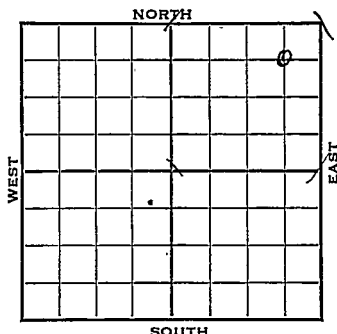

C NE NE Elev. 2220

1942

REPORT

12/2 8" - 150'
Waiting on cement

12/8 Anhy 1700
Drlg. 3009

12/16 Congl. 3721
T.D. 3772'
No shows.

ABANDONED

KANSAS


Graham

Map No. 65 Sec. 21 Twp. 9 R. 21WWell No. 1 KirkpatrickBarnett & R. W. Shields CompanyFIRST REPORT

Contractor

C NE NE

SECTION PLAT

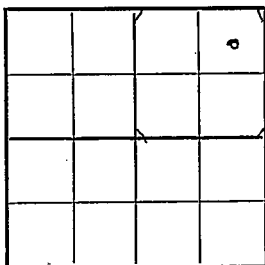660 Ft. from N. Line Ft. from S. Line560 Ft. from E. Line Ft. from W. Line

WIIDCAT

Location Rig up

Drilling and Remarks:

8"-150'

Waiting on
cement

RECORD

Cased in., ft.Sand Gas Oil Total Depth

PRODUCTION

1st 24 hrs. Nat. 1st 24 hrs. after shot Gas Cu. Ft.Dry Hole Abandoned

Date

DEC 2 1942 19

S. J. LEWIS Scout

~~KANSAS~~Map No. 65 Sec. 21 Twp. 9 R. 21 WWell No. 1 KirkpatrickBarnett & R. W. Shields CompanyABANDONED

Contractor

C NE NE

SECTION PLAT

660 Ft. from N. Line

Ft. from S. Line

560 Ft. from E. Line

Ft. from W. Line

			o

WILDCAT

Location

Rig up

Drilling and Remarks:

Comp 63721
Washers

RECORD

Cased _____ in., _____ ft.

Sand _____

Gas _____

Oil _____

Total Depth 3722

PRODUCTION

1st 24 hrs. Nat. _____

1st 24 hrs. after shot _____

Gas _____ Cu. Ft.

Dry Hole _____

Abandoned _____

Date

DEC 16 1942 19S. J. LEWIS

Scout