

35-9-21W

STATE CORPORATION COMMISSION OF KANSAS
OIL & GAS CONSERVATION DIVISION

WELL COMPLETION OR RECOMPLETION FORM
ACO-1 WELL HISTORY

DESCRIPTION OF WELL AND LEASE

Operator: License # 6039
Name L. D. Davis / L. D. Drilling
Address R.R. 1 Box 183 B
City/State/Zip Great Bend, Ks 67530

Purchaser

Operator Contact Person L. D. Davis
Phone 316-793-3051

Contractor: License # 9087
Name R. & C. Drilling, Inc.
Hays, Kansas 67601

Wellsite Geologist
Phone

Designate Type of Completion

- New Well Re-Entry Workover
- Oil SWD Temp Abd
- Gas Inj Delayed Comp.
- Dry Other (Core, Water Supply etc.)

If OWNO: old well info as follows:
Operator K & E Drilling, Inc.
Well Name #1 DeYoung
Comp. Date 11-16-86 Old Total Depth 3925

WELL HISTORY

Drilling Method:
 Mud Rotary Air Rotary Cable

10-27-84	10-30-84	11-7-84
Spud Date	Date Reached TD	Completion Date
3969		
Total Depth	PBTD	

Amount of Surface Pipe Set and Cemented at 209 feet
Multiple Stage Cementing Collar Used? Yes No
If yes, show depth set.....feet
If alternate 2 completion, cement circulated from.....feet depth to.....w/.....SX cmt

API NO. 15-065-01,008

County Graham

N/2 NW SE 35 Sec. 9 Twp. 21 Rge. East West

2310 Ft North from Southeast Corner of Section
1980 Ft West from Southeast Corner of Section

(Note: Locate well in section plat below)


Lease Name Guthrie Well # 1

Field Name

Producing Formation Kansas City

Elevation: Ground 2309 KB 2315 KC-KC

Section Plat

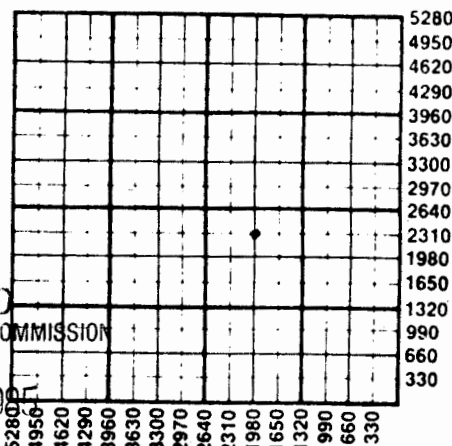

RECEIVED STATE CORPORATION COMMISSION

JAN 17 1987

CONSERVATION DIVISION
Wichita, Kansas WATER SUPPLY INFORMATION
Disposition of Produced Water: Disposal Repressuring
Docket #

Questions on this portion of the ACO-1 call:
Water Resources Board (913) 296-3717

Source of Water:
Division of Water Resources Permit #

Groundwater.....Ft North from Southeast Corner (Well)Ft West from Southeast Corner of Sec Twp Rge East West

Surface Water.....Ft North from Southeast Corner (Stream, pond etc).....Ft West from Southeast Corner Sec Twp Rge East West

Other (explain) hauled (purchased from city, R.W.D. #)

INSTRUCTIONS: This form shall be completed in duplicate and filed with the Kansas Corporation Commission, 200 Colorado Derby Building, Wichita, Kansas 67202, within 90 days after completion or recompletion of any well. Rule 82-3-130 and 82-3-107 apply.

Information on side two of this form will be held confidential for a period of 12 months if requested in writing and submitted with the form. See rule 82-3-107 for confidentiality in excess of 12 months.

WAC-0-2

SIDE TWO

Operator Name J. D. Drilling, Inc. Lease Name Guthrie Well # 1

Sec. 35 Twp. 9 Rge. 21 East West County Graham

WELL LOG

INSTRUCTIONS: Show important tops and base of formations penetrated. Detail all cores. Report all drill stem tests giving interval tested, time tool open and closed, flowing and shut-in pressures, whether shut-in pressure reached static level, hydrostatic pressures, bottom hole temperature, fluid recovery, and flow rates if gas to surface during test. Attach extra sheet if more space is needed. Attach copy of log.

Drill Stem Tests Taken Samples Sent to Geological Survey Cores Taken Yes No Yes No Yes No

Formation Description Log Sample

Name Top Bottom

Washed to old T.D. 3925 then drilled new hole to 3960

METHOD OF COMPLETION

Production Interval

Disposition of gas: Vented Sold Used on Lease Open Hole Perforation Other (Specify) Dually Completed Commingled

Table with 8 columns: Purpose of String, Size Hole Drilled, Size Casing Set (in O.D.), Weight Lbs/Ft., Setting Depth, Type of Cement, #Sacks Used, Type and Percent Additives. Includes handwritten entries for Production and Surface strings.

Table with 3 columns: Shots Per Foot, Specify Footage of Each Interval Perforated, Acid, Fracture, Shot, Cement Squeeze Record (Amount and Kind of Material Used), Depth. Includes handwritten entry for 2 spf.

TUBING RECORD Size Set At Packer at Well is not making oil no tubing Liner Run Yes No