


WELL LOG BUREAU—KANSAS GEOLOGICAL SOCIETY
508 East Murdock, Wichita, Kansas

15-065-00906

Company- THUNDERBIRD DRILLING, INC.
Farm- Bundy No. 1

SEC. 12 T. 9 R. 22W
NW NW NW

Total Depth. 3904'
Comm. 7-23-56 Comp. 8-1-56
Shot or Treated.
Contractor.
Issued. 8-25-56

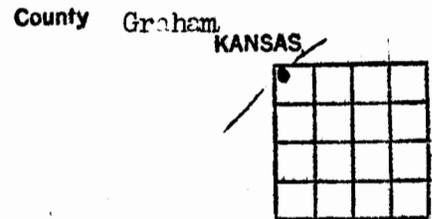

CASING:
8 5/8" 218' w/135 sx. cem

Elevation. 2268' DE

Production. Dry

Figures indicate Bottom of Formations.

surface clay	40
sand & gravel	85
shale	1050
shale & shells	1775
Anhydrite	1805
shale & shells	2210
shale & lime	2875
shale & shells	2900
shale & lime	3455
lime	3806
shale & lime	3875
lime	3904
Total Depth	

TOPS:

Heebner	3484
Lansing	3522
Arbuckle	3879