SIDE ONE

34-9-22 W

STATE CORPORATION COMMISSION OF KANSAS
OIL & GAS CONSERVATION DIVISION
WELL COMPLETION OR RECOMPLETION FORM
ACO-1 WELL HISTORY
DESCRIPTION OF WELL AND LEASE

API NO. 15-065-22,364

Operator: License # 6039
Name L.D. Drilling, Inc.
Address Route 1, Box 183-B
City/State/Zip Great Bend, KS 67530

Purchaser

Operator Contact Person L.D. Davis
Phone 316-793-3051

Contractor: License # 5864
Name Lobo Drilling Co.
Wellsite Geologist Kim Shoemaker
Phone (316) 682-1537

County Graham
250' N & 250' E of
NE SE NW Sec. 34 Twp. 9 Rge. 22 __ East X West

3880 Ft North from Southeast Corner of Section
2720 Ft West from Southeast Corner of Section
(Note: Locate well in section plat below)


Lease Name Sandlin Well # 1

Field Name

Producing Formation

Elevation: Ground 2339 KB 2344

Section Plat

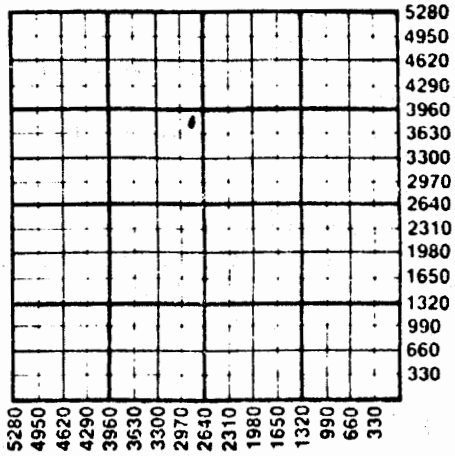

Designate Type of Completion
XX New Well __ Re-Entry __ Workover

__ Oil __ SWD __ Temp Abd
__ Gas __ Inj __ Delayed Comp.
X Dry __ Other (Core, Water Supply etc.)

If OWWO: old well info as follows:
Operator
Well Name
Comp. Date Old Total Depth

WELL HISTORY

Drilling Method:
X Mud Rotary __ Air Rotary __ Cable

4-7-87	4-11-87	
Spud Date	Date Reached TD	Completion Date
3810'		
Total Depth	PBTD	

Amount of Surface Pipe Set and Cemented at 238' feet
Multiple Stage Cementing Collar Used? __ Yes __ No
If yes, show depth set feet
If alternate 2 completion, cement circulated
from feet depth to w/ SX cmt
Cement Company Name
Invoice #

WATER SUPPLY INFORMATION

Disposition of Produced Water: __ Disposal
Docket # __ Repressuring

Questions on this portion of the ACO-1 call:
Water Resources Board (913) 296-3717

Source of Water:
Division of Water Resources Permit #

__ Groundwater Ft North from Southeast Corner
(Well) Ft West from Southeast Corner of
Sec Twp Rge __ East __ West

XX Surface Water Ft North from Southeast Corner
(Stream, pond etc) Ft West from Southeast Corner
Sec Twp Rge __ East __ West

__ Other (explain)
(purchased from city, R.W.D. #)

INSTRUCTIONS: This form shall be completed in triplicate and filed with the Kansas Corporation Commission, 200 Colorado Derby Building, Wichita, Kansas 67202, within 120 days of the spud date of any well. Rule 82-3-130, 82-3-107 and 82-3-106 apply.
Information on side two of this form will be held confidential for a period of 12 months if requested in writing and submitted with the form. See rule 82-3-107 for confidentiality in excess of 12 months.
One copy of all

SIDE TWO

Operator Name L.D. Drilling, Inc. Lease Name Sandlin Well #1

Sec. 34 Twp. 9 Rge. 22 ☐ East ☒ West County Graham

WELL LOG

INSTRUCTIONS: Show important tops and base of formations penetrated. Detail all cores. Report all drill stem tests giving interval tested, time tool open and closed, flowing and shut-in pressures, whether shut-in pressure reached static level, hydrostatic pressures, bottom hole temperature, fluid recovery, and flow rates if gas to surface during test. Attach extra sheet if more space is needed. Attach copy of log.

Drill Stem Tests Taken ☒ Yes ☐ No
Samples Sent to Geological Survey ☒ Yes ☐ No
Cores Taken ☐ Yes ☒ No

DST #1 3707-3746 H Zone
Times: 30-20-20-20
Blow: 1st open: weak blow died in 10 min.
2nd open: no blow
Recovery: 5' oil specked mud
IFP: 49-49 FFP: 51-51 ISIP:70 FSIP: 57

DST #2 3740-3780 J Zone
Times: 20-20-20-0
Blow: 1st open: weak blow died in 12 min.
2nd open: no blow
Recovery: 5' oil specked mud
IFP: 39-39 FFP: 41-41 ISIP: 49 FSIP: 45

DST #3 3775-3810 K Zone
Times: 15-15-5-0
Blow: 1st open: died in 5 min.
2nd open: no blow
Recovery: 10' mud
IFP: 51-51 FFP: 55-58 ISIP: 781 FSIP: -----

Formation Description
☐ Log ☒ Sample

Name	Top	Bottom
Anhy	1842	(-501
Base Anhy	1887	(+456)
Heebner	3548	(-1204)
L. K/C	3584	(-1240)
H Zone	3727	(-1383)
J Zone	3765	(-1421)

CASING RECORD ☐ New ☒ Used
Report all strings set-conductor, surface, intermediate, production, etc.

Purpose of String	Size Hole Drilled	Size Casing Set (in O.D.)	Weight Lbs/Ft.	Setting Depth	Type of Cement	#Sacks Used	Type and Percent Additives
Surface	12¼"	8-5/8"	20#	238'	60/40poz	140	2% gel 3% cc

PERFORATION RECORD		Acid, Fracture, Shot, Cement Squeeze Record	
Shots Per Foot	Specify Footage of Each Interval Perforated	(Amount and Kind of Material Used)	Depth

TUBING RECORD Size Set At Packer at Liner Run ☐ Yes ☐ No