

Rooks

KANSAS

SECTION 22 TOWNSHIP 9 RANGE 16 W

WELL NO. #1 Casey

COMPANY Rupp-Ferguson

NORTH

			0				

WEST

EAST

SOUTH

Rooks

KANSAS

SEC.	TWP.	R.
22	9	16W

WELL NO.

#1-Casey

FARM

COMPANY

Rupp-Ferguson

CONTRACTOR

Co. Tools


WILDCAT

_____ Ft. from N. Line

_____ Ft. from S. Line

_____ Ft. from E. Line

_____ Ft. from W. Line

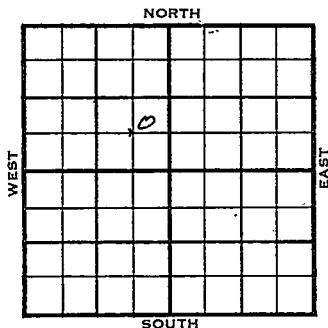

NE SE NW

Gore & Phillips- DHM

	ELEVATION	REPORT
1955	2076'	
11-30	Comm. 11-27-55 8" @ 196/140 Drlg. 1965	
12-7	DST 3245-3305 op 1 hr. rec. 30' mud 25/15" D & A Tarkio 2704 Harvard 2968 Topeka 2993 Heeb 3192 Tor. 3210 Lans. 3233 BKG 3485 C. 3555 A 3629 TD 3669'	

ABANDONED

County Rooks Elev. _____
 Sec. 22 Twp. 9 Rge. 16W
 Company Rupp-Ferguson
 FarmName Casey No. 1

TOPS	DEPTH	LOG	DATUM
Anh.			
TP.			
H.			
Tr.			
Dg.			
Bl.			
L.			
K.C.			
B.K.C.			
Ce.			
C.			
M.			
M.			
K.			
Mz.			
Me.			
V.			
S.			
S.			
A.			
R.			
PE.			
G.			
T.D.			


Loc. in Sec. NE SE NW

Geol. _____
 Contr. Co. tools

Pool Wildcat

NOV 30 '55
 0
 FIRST REPORT

Date Comm. 11-27-55 Gore & Phillips - DHM
8" @ 196/140 drlg. 1965

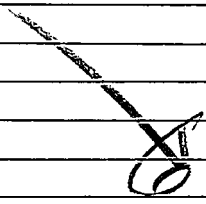

Co.
Lse.
No.
Sec.
T.
R.

County Rooks Elev. 2076
 Sec. 22 Twp. 9 Rge. 16W
 Company Rupp Ferguson
 Farm Name Casey No. 1

TOPS	DEPTH	LOG	DATUM	Loc. in Sec.
Anh.				
Tp. <u>Jarbin</u>	<u>2704</u>		<u>628</u>	<u>NE SE NW</u>
H. <u>Howard</u>	<u>2968</u>		<u>892</u>	
To. <u>behn</u>	<u>2993</u>		<u>917</u>	
Dg. <u>U. Weck</u>	<u>3192</u>		<u>1416</u>	
Bl. <u>7. 2. 1.</u>	<u>3210</u>		<u>1134</u>	
L. <u>Lamar</u>	<u>3233</u>		<u>1157</u>	Geol. _____
K.C.				Contr. _____
B.K.C.	<u>3485</u>		<u>1409</u>	Co. tools _____
Ce.				Pool _____
C.	<u>3555</u>		<u>1479</u>	<u>Wildcat</u>
M.				
M.				
K.				
Mz.				
Mo.				
V.				
S.				
S.				
A.	<u>3629</u>		<u>1553</u>	
R.				
Pe.				
G.				
T.D.	<u>3669</u>			

ABANDONED

Date Comm. 11-27-55 DEC 7 1955

8" @ 196/140 DST 3245-3305 open 1 hr.

rec. 30' mud 25/15"

D & A