

Rooks

Form 51-5M-9-28-27423

Map No. **KANSAS** Sec. *22* Twp. *9* R. *19^w*


Well No. *1 - Gick* Farm

Prairie Oil & Gas Company

NORTH

WEST

EAST

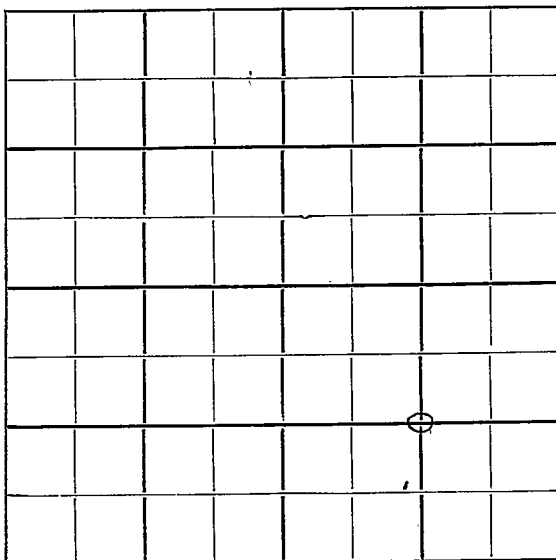

SOUTH

Location.....

Drilling Remarks.....

1479

Rig Up.....

Drilling Remarks.....

RECORD

Cased..... in..... ft.

Sand.....

Gas.....

Oil.....

Total Depth.....

PRODUCTION

1st 24 hrs. Nat.....

1st 24 hrs. after shot.....

Gas..... cu. ft.....

Dry Hole.....

Abandoned.....

Map No. KANSAS Sec. 22 Twp. 9 R. 19W

Well No. 1- Hick Farm


Prairie Oil & Gas Company

_____ Ft. from N. Line

1320 Ft. from S. Line

1320 Ft. from E. Line

_____ Ft. from W. Line

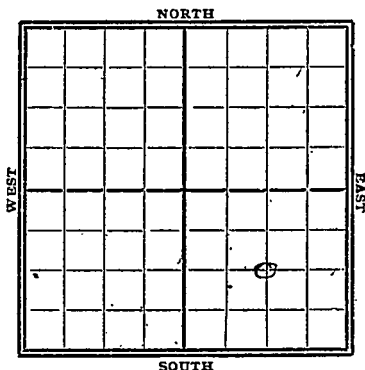

1928

Date	REPORT
11/28	RoG.
12/5	Rig
12/12	
12/19	
12/26	
1929	
1/2	Rign up
1/9	drlg 410'
1/16	" 684'
1/23	" 810'
1/30	U1R 15 1/2" - 920' T.D.
2/6	drlg 982'
2/13	U1R 15" - 1080' - T.D.
2/20	drlg 1310'
2/27	" 1440'
3/6	" 1530'
3/13	rng 12" csg. 1533'
3/20	drlg 1725'
3/27	" 2200'
4/3	" 2625'
4/10	" 2950' 10" - 2612
4/17	" 3035'

4/24 - Only 3135'
5/1 - S.D. 3135'
5/8 - Only 3190'
5/15 - " 3315'
5/22 - " 3415'
5/29 - S.D. 3585'
6/5 - 3585 - U.R. 6"
6/12 - 3640 - U.R. 6"
6/19 - Only 3715'
6/26 - " 3750
7/2 - " 3780
7/10 - " 3905'
7/17 - " 4050'
7/24 - Top Granite 4115
TD 4127'
Abandon


Book no having
 MAP NO. KANSAS SEC. 22 TWP. 9 R. 18 W

WELL NO. 1 Gick

Prairie Oil & Gas COMPANY

CONTRACTOR

SECTION PLAT

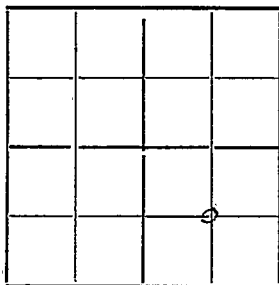

_____ FT. FROM N. LINE

1320 FT. FROM S. LINE

1320 FT. FROM E. LINE

_____ FT. FROM W. LINE

FIRST REPORTS

RECORD

LOCATION _____

CASED _____ IN. _____ FT.

RIG UP _____

SAND _____

DRILLING AND REMARKS:

GAS _____

OIL _____

TOTAL DEPTH _____

ROG

PRODUCTION

1ST 24 HRS. NAT. _____

1ST 24 HRS. AFTER SHOT _____

GAS _____ CU. FT.

DRY HOLE _____

ABANDONED _____

DATE

NOV 28 1928 192

S. J. LEWIS

SCOUT

Map No. KANSAS Sec. 22 Twp. 9 R. 19W

Well No. 58 1 Gick

Prairie O & G Company

Contractor


SECTION PLAT

1320 Ft. from N. Line

1320 Ft. from S. Line

1320 Ft. from E. Line

1320 Ft. from W. Line

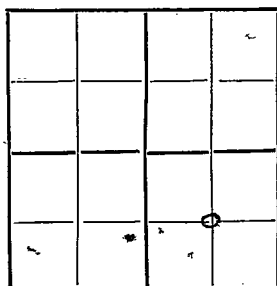

ABANDONED

Location

Rig up

Drilling and Remarks:

Top Gran to
4115

RECORD

Cased in. ft.

Sand

Gas

Oil

Total Depth 4127

PRODUCTION

1st 24 hrs. Nat.

1st 24 hrs. after shot

Gas Cu. Ft.

Dry Hole

Abandoned

Date

JUL 24 1929 S. J. LEWIS Scout