


Section 22 Township 9 Range 20W

Well No. 1 Steeples

Company Barnett Drlg.

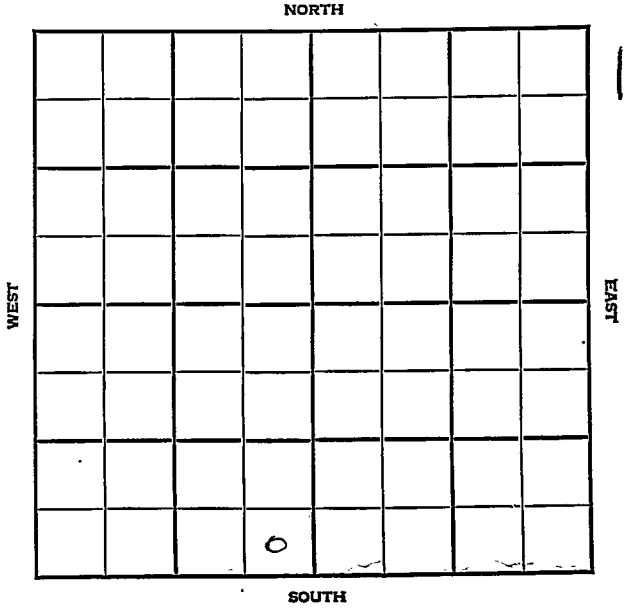



Sec. 22 Twp. 9 R. 20W

Well No. #1 Steeples Farm

Barnett Drlg. Company

Wildcat


 Ft. from N. Line

330 Ft. from S. Line

330 Ft. from E. Line

 Ft. from W. Line

SE SW

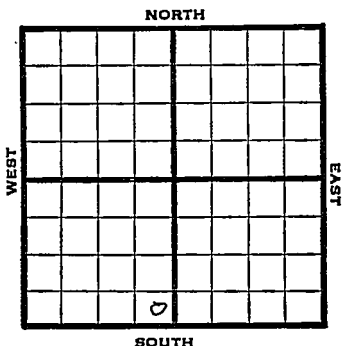

1948

Elev. 2234' REPORT

4/28

RUR

5/5

8" @ 134'

Drlg. 1840'

5/12

Drlg. 3690'

5/19

Lans. 3478'

BKC 3744'

Congl. 3789'

TD 3834 in Congl.

ABANDONED

Map No. _____ Sec. 22 Twp. 9 R. 20W

Well No. 1 Steeples

Barnett Drlg. Company

FIRST REPORT Contractor

SE SW

SECTION PLAT

_____ Ft. from N. Line

330 Ft. from S. Line

330 Ft. from E. Line

_____ Ft. from W. Line

Rooks County

Location _____

Rig up _____

Drilling and Remarks:

R U R

RECORD

Cased _____ in., _____ ft.

Sand _____

Gas _____

Oil _____

Total Depth _____

PRODUCTION

1st 24 hrs. Nat. _____

1st 24 hrs. after shot _____

Gas _____ Cu. Ft.

Dry Hole _____

Abandoned _____

Date

APR 28 1948 19_____

S. J. LEWIS Scout

Map No. 65 Sec. 22 Twp. 9 R. 20W

Well No. 1 Steeples

Barnett Drlg. Company

ABANDONED Contractor

SE SW

E12284
SECTION PLAT

 Ft. from N. Line

330 Ft. from S. Line

330 Ft. from E. Line

 Ft. from W. Line

Rooks County

Location

Rig up

Drilling and Remarks:

Lane 3478
BKC 3744
Cong 3789

RECORD

Cased in., ft.

Sand

Gas

Oil

Total Depth 3834 in Cong

PRODUCTION

1st 24 hrs. Nat.

1st 24 hrs. after shot

Gas Cu. Ft.

Dry Hole

Abandoned

Date

MAY 19 1948 19

S. J. LEWIS Scout