

KANSAS

Rooks

Section 22 Township 9 Range 20WWell No. 1 SteeplesCompany P. Wentworth et al

Hampton

NORTH

WEST

EAST

SOUTH

16

0

Rooks

KANSAS



Sec. 22 Twp. 9 R. 20W

Well No. #1 Steeples Farm

P. Wentworth et al Company

Hampton (Wentworth, Cont.)
Pool


Ft. from N. Line

330' Ft. from S. Line

330' Ft. from E. Line

Ft. from W. Line

SE/C

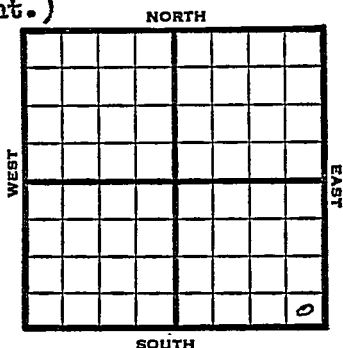

1949

Elev 2273' REPORT

8/10 RUR

8/17 8" @ 185'

8/24 Lansing 3564?
Drlg. 3570'

8/31 TD 3983'

Top 3306'

Lans 3562'

Gong 3844'

Arb. 3970'

Aband.

ABANDONED

Map No. _____ Sec. 22 Twp. 9 R. 20W

Well No. 1 Steeples


P. Wentworth et al. Company

Wentworth

Contractor

SE/C

**FIRST REPORT
SECTION PLAT**

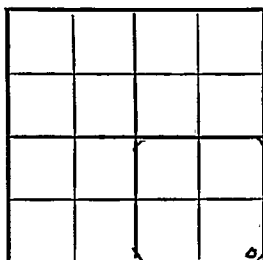

_____ Ft. from N. Line

330 Ft. from S. Line

330 Ft. from E. Line

_____ Ft. from W. Line

Rooks County

Location _____

Rig up _____

Drilling and Remarks:

R U R

RECORD

Cased _____ in., _____ ft.

Sand _____

Gas _____

Oil _____

Total Depth _____

PRODUCTION

1st 24 hrs. Nat. _____

1st 24 hrs. after shot _____

Gas _____ Cu. Ft.

Dry Hole _____

Abandoned _____

Date

AUG 10 1949

19

S. J. LEWIS

Scout

Kansas


Map No. K65 Sec. 22 Twp. 9 R. 20WWell No. 1 SteeplesP. Wentworth et al.

Company

ABANDONED

Contractor

SE/C

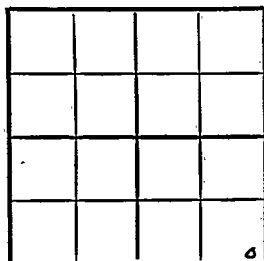E1, 2223
SECTION PLAT Ft. from N. Line330 Ft. from S. Line330 Ft. from E. Line Ft. from W. Line

Rooks County

RECORD

Location Cased in., ft.Rig up Sand

Drilling and Remarks:

Gas Oil Total Depth 2995

PRODUCTION

1st 24 hrs. Nat. 1st 24 hrs. after shot Gas Cu. Ft.Dry Hole Abandoned

Date

AUG 31 1949

19

S. J. LEWIS

Scout