


Section 22 Township 9 Range 20W

Well No. #1 Steeples

Company Petroleum, Inc.

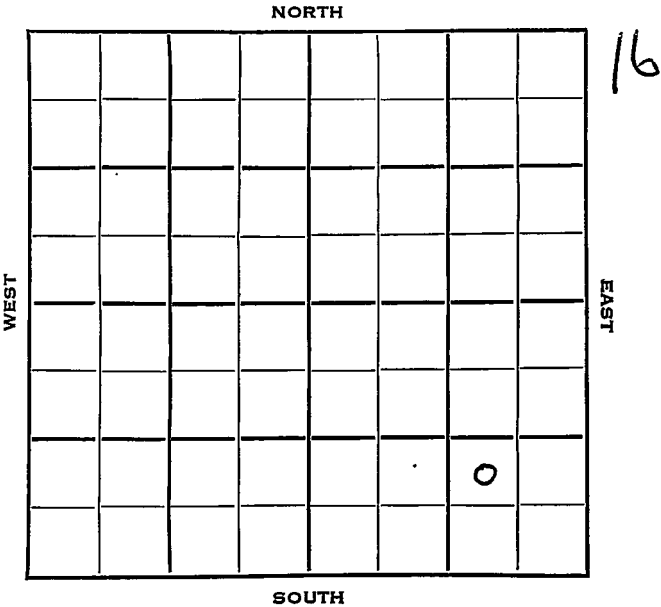

Rooks

KANSAS



Sec. 22 Twp. 9 R. 20 W

Well No. # 1 Steeples Farm

Petroleum Inc. Company

Contractor


Ft. from N. Line

990 Ft. from S. Line

990 Ft. from E. Line

Ft. from W. Line

NW SE SE

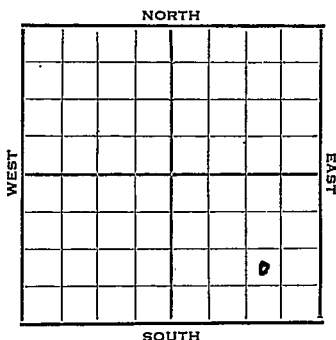

1953

Elev. 2253'

REPORT

7/29

Drlg.

8/5

Spud 7-24-53

D&A

TD 3968

8" @ 192

Anhy 1740, Heeb 3504, Tor 3524, Lans 3540

DST 3572-3650, opn 1 hr., rec. 1475' sw, 1290#

DST 3705-64, opn 3/4 hrs., rec. 6' mud, 0#

Cong 3830, Arb 3955


TD 3968

D&A

ABANDONED

J. G. McGEHEE

County _____ Rocks _____ State Kansas
 Sec. 22 (Blk. Twp.) 9 (Sur. Rge.) 20W Map No. _____
 Operator Petroleum Inc.
 Well No. 1 Farm Steeple
 Elev. 2253 Location NW SE SE

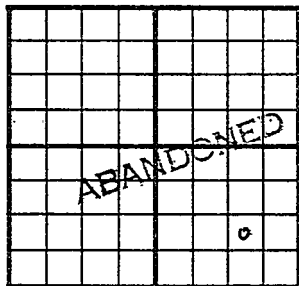

990 Ft. From S Line SE

990 Ft. From E Line Quarter

1st. Report _____

Completion AUG 5 1953

Remarks _____

Spudding Date 7-24-53

Drlg. Data D & A TD 3968

8" @ 192 Anhy 1740 Heeb. 3504

Tor. 3524 Lans. 3540 DST 3572-3650

open 1 hr. Rec. 1475' sw 1290#

DST 3705-64 open 3/4 hr. Rec. 6' mud

0# Cong. 3830 Arb. 3955 TD 3968

D & A

J. G. McGEHEE