


Section 22 Township 9 Range 21W

Well No. 3 Darnell

Company Cities Service Oil

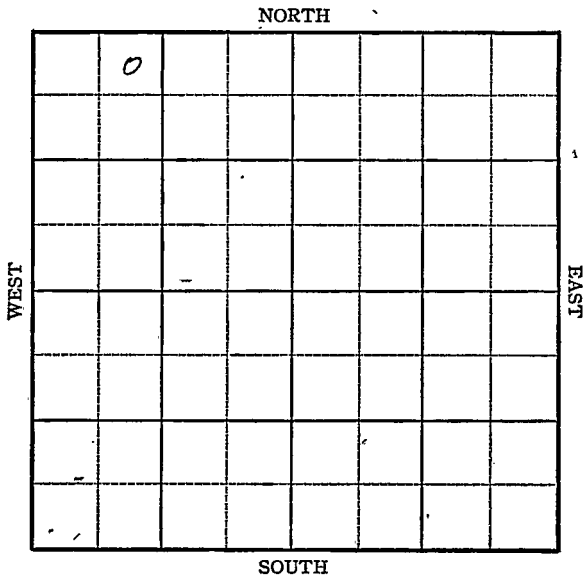

KANSAS

Graham

Sec. 22 Twp. 9 R. 21-W

Well No. # 3 Darnell Farm


Cities Service Oil Company

330 Ft. from N. Line

Ft. from S. Line

Ft. from E. Line

990 Ft. from W. Line

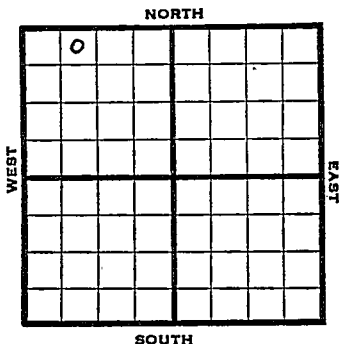

NE NW NW Elev. 2279

1945

REPORT

9/53 Location
9/12 8" @ 215
Drilg. 1750
9/19 Drilg. 3480
9/26¹/₂ Lens 3468
Simp 3766
Arb. 3775-3780
TD 3780
5" @ 3776
2800' oil in 9¹/₂ hrs.

10/3 Arb. 3775
5" @ 3776
TD 3780'
Depth Pot. 1140
Grav. 29.3

COMPLETED

KANSAS

Pool Name MoretMap No. 65 Sec. 22 Twp. 9 R. 21WWell No. 3 DarnellCities Service Oil CompanyFIRST REPORT Contractor

NE NW NW

SECTION PLAT

<u>6</u>			

330 Ft. from N. Line Ft. from S. Line Ft. from E. Line990 Ft. from W. LineGraham CountyLocation XRig up

Drilling and Remarks:

RECORD

Cased in., ft.Sand Gas Oil Total Depth

PRODUCTION

1st 24 hrs. Nat. 1st 24 hrs. after shot Gas Cu. Ft.Dry Hole Abandoned

Date

SEP 5 1945 19 S. J. LEWIS Scout

KANSAS ~~Kansas~~ Pool Name Morel PoolMap No. 65 Sec. 22 Twp. 9 R. 21WWell No. 3 Darnell

Cities Service Oil

Company

COMPLETED

Contractor

NE NW NW

E1.2278
SECTION PLAT330 Ft. from N. Line Ft. from S. Line Ft. from E. Line990 Ft. from W. Line

4			

Graham County

Location Rig up

Drilling and Remarks:

Cr 83775
5" @ 83776
Dep 1008
1140

293 gr

RECORD

Cased in., ft.Sand Gas Oil Total Depth 3280

PRODUCTION

1st 24 hrs. Nat. 1st 24 hrs. after shot Gas Cu. Ft.Dry Hole Abandoned

Date

OCT 3 1945 19S. J. LEWIS

Scout