KANSAS


FORM 51 5M 6-46 PETROL

Graham County

Section 22 Township 9 Range 21W

Well No. #5 Darnell

Company Cities Service

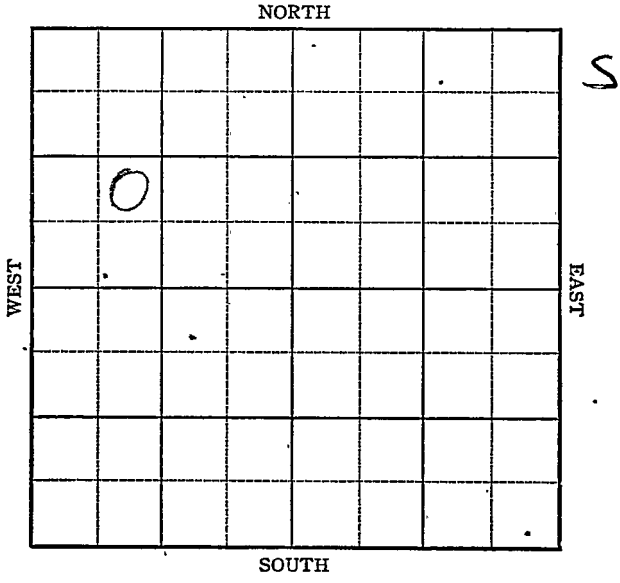

FORM 252-A
5M 6-46 PETROL

KANSAS

Graham County ✓

Sec. 22 Twp. 9 R. 21W

Well No. #5 Darnell Farm

Cities Service Company

Norel


____ Ft. from N. Line

990 Ft. from S. Line

____ Ft. from E. Line

990 Ft. from W. Line

NE SW NW

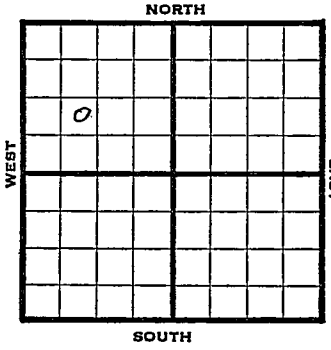

1946	2270 REPORT
7/24	RUR
7/30	8" @ 215 Drlg 2165'
8/6	Drlg 3640'
8/13	Lans 3457 BKC 3691 Simp 3741 Arb 3754 5" @ 3755 TD 3771-2725' oil in 2 hrs
8/21	Arb. 3754 5" @ 3755 TD 3771 Depth Pot. 3169 Max. 3000 Grav. 28.0

COMPLETED

FORM 56 200 BKS. 1-44 PETROL

KANSAS Kansas Pool Name Norel

Map No. 65 Sec. 22 Twp. 9 R. 21W


Well No. 5 Darnell

Cities Service Company

FIRST REPORT Contractor

NE SW NW

SECTION PLAT

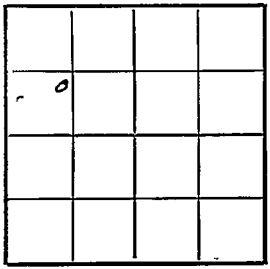

____ Ft. from N. Line

990 Ft. from S. Line

____ Ft. from E. Line

990 Ft. from W. Line

Graham County

Location

Rig up

Drilling and Remarks:

R U R

RECORD

Cased ____ in., ____ ft.

Sand

Gas

Oil

Total Depth

PRODUCTION

1st 24 hrs. Nat.

1st 24 hrs. after shot

Gas ____ Cu. Ft.

Dry Hole

Abandoned

Date

JUL 24 1946 19

S. J. LEWIS Scout

FORM 56 200 BKS. 1-44 PETROL

KANSAS Kansas

Pool Name Morel

Map No. 6 J Sec. 22 Twp. 9 R. 21W

Well No. 5 Darnell


Cities Service Company

COMPLETED Contractor

NE SW NW

E 1,2270

SECTION PLAT

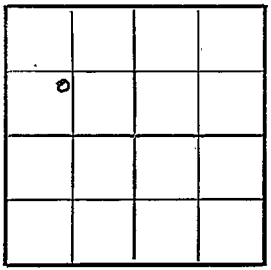

Ft. from N. Line

990 Ft. from S. Line

Ft. from E. Line

990 Ft. from W. Line

Graham County

Location

Rig up

Drilling and Remarks:

Ac T.D. 3754

5" @ 3755

Dep. to P.B.D. 3769

Max. 800 #

28° Gr.

RECORD

Cased in., ft.

Sand

Gas

Oil

Total Depth 3771

PRODUCTION

1st 24 hrs. Nat.

1st 24 hrs. after shot

Gas Cu. Ft.

Dry Hole

Abandoned

Date

AUG 21 1946 19

S. J. LEWIS Scout