

Section 22 Township 9 Range 21WWell No. #6 DarnellCompany Cities Service

	0						

NORTH

WEST

EAST

SOUTH

24

KANSAS

Graham

Sec. 22 Twp. 9 R. 21-W

Well No. #6 Darnell Farm

Cities Service Company

Holm Drlg. Contractor

Morel


990 Ft. from N. Line

 Ft. from S. Line

 Ft. from E. Line

990 Ft. from W. Line

SE NW NW

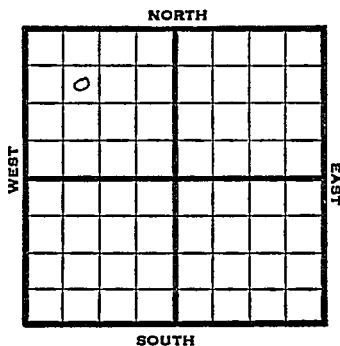

1950 Elev. 2262' REPORT

9/27 Location

11/22 Spud 9-27-50
Oil Well TD 3770'
8" @ 275'
Arb. 3763' TD 3768 5" @ 3766
Dodge 3682' Cong. 3751'
Simp. 3753' Sh 3755'
TD 3770' FU 241' oil 2060'
wtr 16 hr. P/33 BO 114 BWPD
Comp. 31 BOPD 90% wtr.

COMPLETED



Sec. 22 (Blk.) 9 (Sur.) 21W Map No.

Well No. 6 Farm Darnell

Elev.	Location	SE	NW	NW
-------	----------	----	----	----

0

FIRST REPORT

990 Ft. From N Line END

990 Ft. From W Line Quarter

1st. Report SEP 27 1950

Completion

Remarks


Holm Drlg. - Contr.

Spudding Date

Drlg. Data Morel Pool

Location

J. E. TYRA

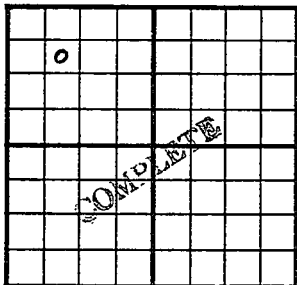County Graham State KansasSec. 22 (Blk. 9 (Sur. 21W Map No. 21W) (Twp.)Operator Cities ServiceWell No. 6 Farm DarnellElev. 2262 Location SE NW NW990 Ft. From N Line NW990 Ft. From W Line QuarterIst. ReportCompletion NOV 22 1950Remarks Morel PoolRine Drlg. - Contr.Spudding Date 9-27-50Drlg. Data Oil well TD 37708" @ 275 Arb. 3763 TD 3768 5" @ 3766Dodge 3682 Cong. 3751 Simp. 3753Sh. 3755 TD 3770 FU 241' oil 2060'water 16 hr. P/ 33 bo 114 bopdComp. 31 bopd 90% water