

Graham


KANSAS

FORM 51 5M 10-41 PETROL

Section 22 Township 9 Range 21-W

Well No. #1 Morel

Company Cities Service 0.1

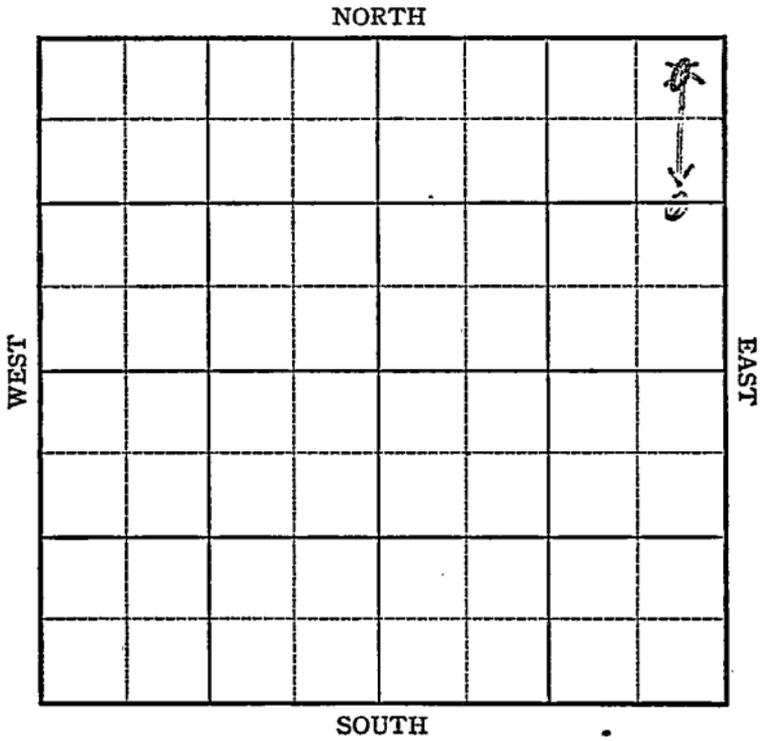

**KANSAS**

Graham

Sec. 22 Twp. 9 R. 21-W

Well No. #1 Morel Farm

Cities Service Oil Company

(Morel)


~~550~~ <sup>1370</sup> Ft. from N. Line

\_\_\_\_\_ Ft. from S. Line

330 Ft. from E. Line

\_\_\_\_\_ Ft. from W. Line

Elev. 2277

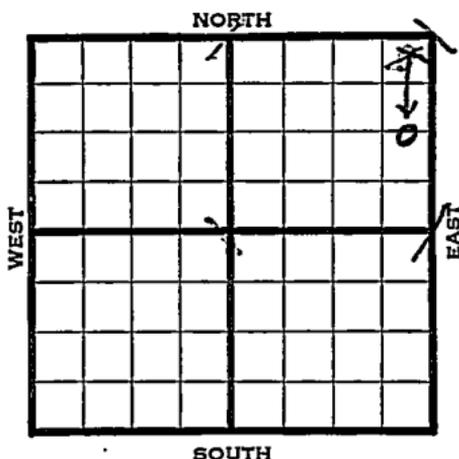


1941	REPORT
11/19	Location
11/26	Rotary.
12/4	8" - 210' Drlg. 2700'
12/11	Art. 3779 3780
	TD 5" @ 3780 RUST
12/18	Arb. 3774 (Corrected)
	5" @ 3775
	TD 3777-2950' oil 3/4 hr.
12/23	Arb. 3774'
	5" - 3775'
	T.D. 3777'
	Echometer potential 15,890 bbls.
	Maximum 3000 bbls.
	29.3 Gravity
	<b>COMPLETED</b>

Map No. K-65 Sec. 22 Twp. 9 R. 21WWell No. 1 MorelCities Service Oil Company**FIRST REPORT** Contractor

NE/C

## SECTION PLAT

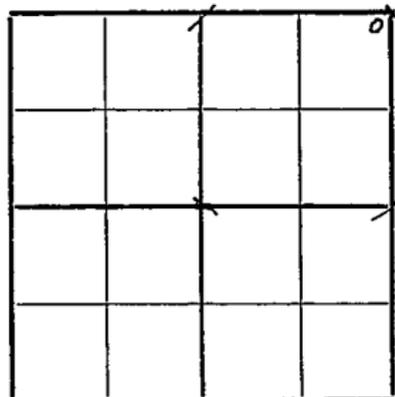330 Ft. from N. Line       Ft. from S. Line330 Ft. from E. Line       Ft. from W. Line

MOREL POOL

Location XXRig up       Drilling and Remarks:       

## RECORD

Cased        in.,        ft.Sand       Gas       Oil       Total Depth       

## PRODUCTION

1st 24 hrs. Nat.       1st 24 hrs. after shot       Gas        Cu. Ft.Dry Hole       Abandoned       

Date

NOV 19 1941S. J. LEWIS Scout

Graham

KANSAS

Map No. 11-65 Sec. 22 Twp. 9 R. 21WWell No. 1 MorelCities Service Oil CompanyCORRECTION Contractor

C E L N E

## SECTION PLAT

1370 Ft. from N. Line

\_\_\_\_\_ Ft. from S. Line

330 Ft. from E. Line

\_\_\_\_\_ Ft. from W. Line

			0

MOREL POOL

Location \_\_\_\_\_

Rig up \_\_\_\_\_

Drilling and Remarks:

First reported

NE/C

## RECORD

Cased \_\_\_\_\_ in., \_\_\_\_\_ ft.

Sand \_\_\_\_\_

Gas \_\_\_\_\_

Oil \_\_\_\_\_

Total Depth \_\_\_\_\_

## PRODUCTION

1st 24 hrs. Nat. \_\_\_\_\_

1st 24 hrs. after shot \_\_\_\_\_

Gas \_\_\_\_\_ Cu. Ft.

Dry Hole \_\_\_\_\_

Abandoned \_\_\_\_\_

Date

NOV 25 1941 19S. J. LEWIS Scout

KANSAS

Map No. 65 Sec. 22 Twp. 9 R. 21WWell No. 1 MorelCities Service Oil CompanyCOMPLETED Contractor

C E L N E

SECTION PLAT

1370 Ft. from N. Line

\_\_\_\_\_ Ft. from S. Line

330 Ft. from E. Line

\_\_\_\_\_ Ft. from W. Line


MOREL POOL

## RECORD

Location \_\_\_\_\_

Cased \_\_\_\_\_ in., \_\_\_\_\_ ft.

Rig up \_\_\_\_\_

Sand \_\_\_\_\_

Drilling and Remarks:

Gas \_\_\_\_\_

Oil \_\_\_\_\_

*Cur 8774*Total Depth 2227*5-108795**Ech 15890**Max 8000*

## PRODUCTION

1st 24 hrs. Nat. \_\_\_\_\_

1st 24 hrs. after shot \_\_\_\_\_

Gas \_\_\_\_\_ Cu. Ft.

Dry Hole \_\_\_\_\_

Abandoned \_\_\_\_\_

*293 G*

Date

DEC 23 1941 19 S. I. LEWIS Scout