

KANSAS

FORM 51 25M 8-50 WESTERN

Graham

Section 22 Township 9 Range 21-W

Well No. #7 Morel

Company Cities Service

NORTH

							0

WEST

EAST

SOUTH

8

Sec. 22 Twp. 9 R. 21W ✓

Well No. #7 Morel Farm

Cities Service Company

Rine Drlg. - Contr. Contractor

Morel Pool


 Ft. from N. Line

330' Ft. from S. Line

330' Ft. from E. Line

 Ft. from W. Line

SE SE NE

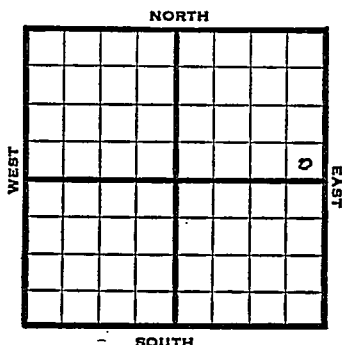

1950

Elev. 2290' REPORT

11/15

Location

1951

1/10

Spud 11-26-50

Oil Well TD 3786

8" @ 240' Lans. 3490 Arb. 3778

TD 3780 5" @ 3779

DD 3786 FU 2630' oil 9½ hr

Comp. 2779 bopd 5% wtr

COMP. W'FEE

County Graham State KansasSec. 22 (Blk. Twp.) 9 (Sur. Rge.) 21W Map No.Operator Cities ServiceWell No. 7 Farm MorelElev. Location SE SE NE

FIRST REPORT

330 Ft. From S Line NE330 Ft. From E Line QuarterIst. Report NOV 15 1950

Completion

Remarks


Spudding Date

Drlg. Data Morel Pool

Location

J. E. TYRA

County Graham State Kansas
 Sec. 22 (Blk.) 9 (Sur.) 21W Map No.
 Operator Cities Service
 Well No. 7 Farm Morel
 Elev. 2290 Location SE SE NE

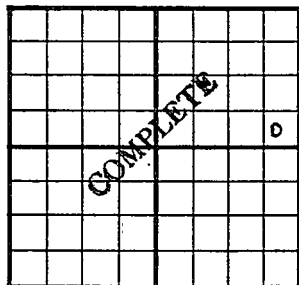

330 Ft. From S Line NE
330 Ft. From E Line Quarter
 Ist. Report
 Completion JAN 10 1951
 Remarks Morel Pool
Rine Drlg. - Contr.
 Spudding Date 11-26-50

Drlg. Data Oil well TD 3786
8" @ 240 Lans. 3490 Arb. 3778 TD 3780
5" @ 3779 DD 3786 FU 2630' oil 9½ hr.
Comp. 2779 bopd 5% water

J. E. TYRA