


KANSAS

Graham

Section 22 Township 9 Range 21-W

Well No. #6 Sutor

Company Derby etal

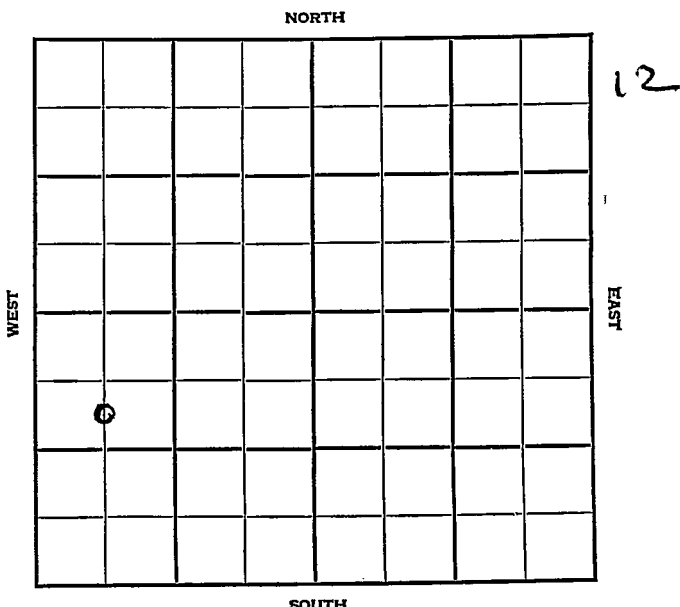

KANSAS

Graham

Sec. 22 Twp. 9 R. 21W

Well No. #6 Sutor Farm

Derby et al Company

Morel Pool


990' Ft. from N. Line

Ft. from S. Line

Ft. from E. Line

660' Ft. from W. Line

C S L. NW SW

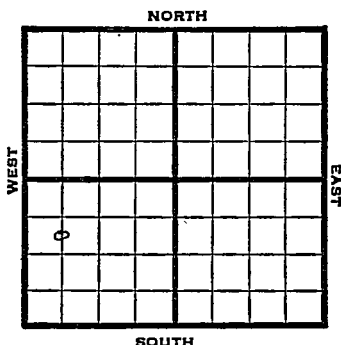

1948

Elev. 2281' REPORT

5/5 Location

5/12 8" @ 350'
WOC

5/19 Drlg. 875'

5/26 Lansing 3495'
BKC 3720'
Arbuckle 3802'
TD 3806'
5" @ 3803'
200 oil
500 acid

6/1 Swb 40 bbls oil PH 3 hrs.

6/9 "

6/16 TD 3803'
Arb 3802'
5"@ 3803' 500 acid
Echo Pot 3000 Oil
275 Gr.
Comp.

COMPLETED

Map No. _____ Sec. 22 Twp. 9 R. 21W

Well No. 6 Sutor

Derby etal. Company

FIRST REPORT Contractor

C S L NW SW

SECTION PLAT

990 Ft. from N. Line

_____ Ft. from S. Line

_____ Ft. from E. Line

660 Ft. from W. Line

o			

Graham County

Location X

Rig up _____

Drilling and Remarks:

RECORD

Cased _____ in., _____ ft.

Sand _____

Gas _____

Oil _____

Total Depth _____

PRODUCTION

1st 24 hrs. Nat. _____

1st 24 hrs. after shot _____

Gas _____ Cu. Ft.

Dry Hole _____

Abandoned _____

Date

MAY 5 1948

19

S. J. LEWIS Scout

Map No. 65 Sec. 22 Twp. 9 R. 21W

Well No. 6 Sutor

Derby etal. Company

COMPLETE

C S L NW SW

Contractor

E. 2287

SECTION PLAT

990 Ft. from N. Line

 Ft. from S. Line

 Ft. from E. Line

660 Ft. from W. Line

0			

Graham County

Location

Rig up

Drilling and Remarks:

Ci & 3802
5' 0382
500 acc'd
Ech & 3800 acc'd

27 5/8

RECORD

Cased in., ft.

Sand

Gas

Oil

Total Depth 3802

PRODUCTION

1st 24 hrs. Nat.

1st 24 hrs. after shot

Gas Cu. Ft.

Dry Hole

Abandoned

Date

JUN 16 1948

19

S. J. LEWIS Scout