


Section 22 Township 9 Range 21-W

Well No. #6 Morel "B"

Company Cities Service
Morel Pool

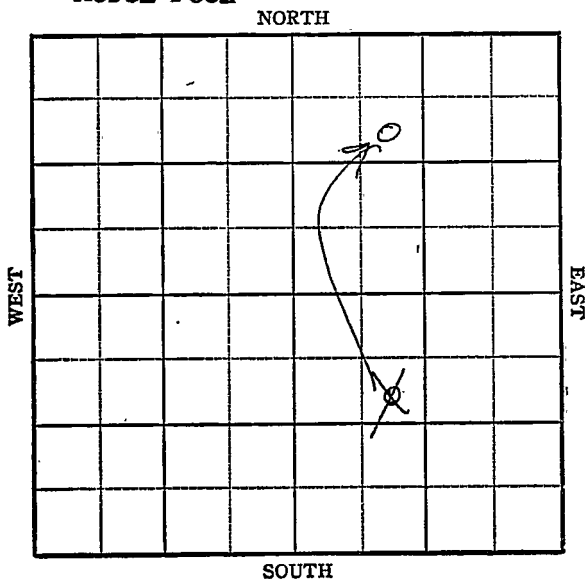

KANSAS

Graham

Sec. 22 Twp. 9 R. 21W ✓

Well No. #6 Morel "B" Farm

Cities Service

Company


Morel Pool

990' Ft. from N. Line

 Ft. from S. Line

 Ft. from E. Line

990' Ft. from W. Line

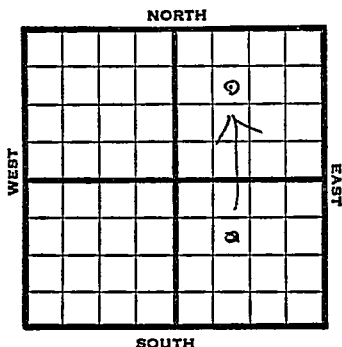

~~SE NW SE~~

SE NW NE

1948

Elev 2265' REPORT

12/1 Location
12/8 8" @ 257'
Drlg 430'
12/15 Drlg 3000
12/22 Arbuckle 3743'
TD 3745
5" @ 3744'
12/29 Lansing 3451'

1949

1/12 TD 3752'
Arb 3743'
5" @ 3744'
500 acid
Pump 400 Oil / 4% W Pot
30° Gr.
Comp

COMPLETED

Map No. _____ Sec. 22 Twp. 9 R. 21W

Well No. 6 Morel "B"

_____ Cities Service _____ Company

_____ **FIRST REPORT** _____ Contractor

SE NW SE


SECTION PLAT

990 Ft. from N. Line

_____ Ft. from S. Line

_____ Ft. from E. Line

990 Ft. from W. Line

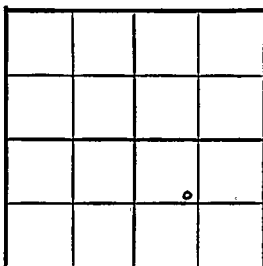

Graham County

Location X

Rig up _____

Drilling and Remarks:

RECORD

Cased _____ in., _____ ft.

Sand _____

Gas _____

Oil _____

Total Depth _____

PRODUCTION

1st 24 hrs. Nat. _____

1st 24 hrs. after shot _____

Gas _____ Cu. Ft.

Dry Hole _____

Abandoned _____

Date

DEC 1 1948 19

S. J. LEWIS

Scout

Map No. 65 Sec. 22 Twp. 9 R. 21W

Well No. 6 Morel "B"

Cities Service Company

CORRECTION Contractor

SE NW NE

SECTION PLAT

990 Ft. from N. Line

 Ft. from S. Line

 Ft. from E. Line

990 Ft. from W. Line

		a	

Graham County

Location

Rig up

Drilling and Remarks:

Reported

SE NW SE

RECORD

Cased in., ft.

Sand

Gas

Oil

Total Depth

PRODUCTION

1st 24 hrs. Nat.

1st 24 hrs. after shot

Gas Cu. Ft.

Dry Hole

Abandoned

Date

DEC 8 1948 19 S. J. LEWIS Scout

Kansas

Map No. 65 Sec. 22 Twp. 9 R. 21WWell No. 6 Morel "B"


Cities Service

Company

COMPLETE

Contractor

SE NW NE

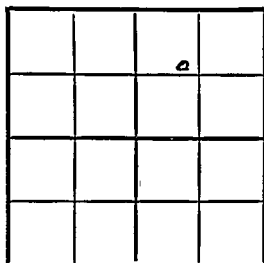E. 2265
SECTION PLAT990 Ft. from N. Line Ft. from S. Line Ft. from E. Line990 Ft. from W. Line

Graham County

RECORD

Location Cased in. ft.Rig up Sand

Drilling and Remarks:

Gas Oil Total Depth 8752

PRODUCTION

1st 24 hrs. Nat. 1st 24 hrs. after shot Gas Cu. Ft.Dry Hole Abandoned

Date

JAN 12 1949 19

S. J. LEWIS

Scout

Cr 37435" @ 37445000 oilProd 400 oil + 49WPS3000