

KANSAS

FORM 51 5M 10-41 PETROL

Graham

Section 22 Township 9 Range 21-W

Well No. #1 Sutor


Company Cities Service Oil

Morel Pool

NORTH

WEST

EAST

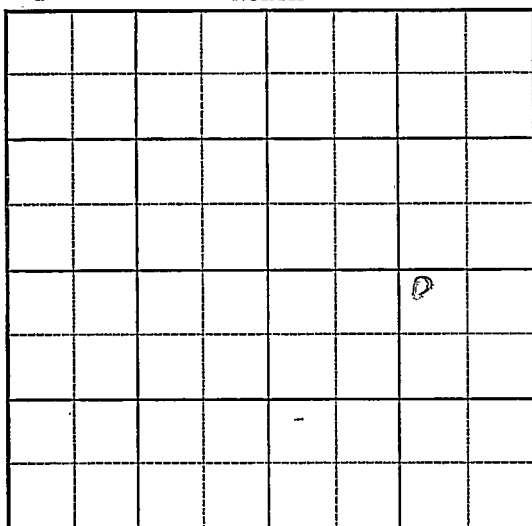

SOUTH

KANSAS

Graham

Sec. 22 Twp. 9 R. 21-W

Well No. #1 Sutor Farm

Cities Service Oil Company
(Morel Pool)


330 Ft. from N. Line

Ft. from S. Line

990 Ft. from E. Line

Ft. from W. Line

Elev. 2300

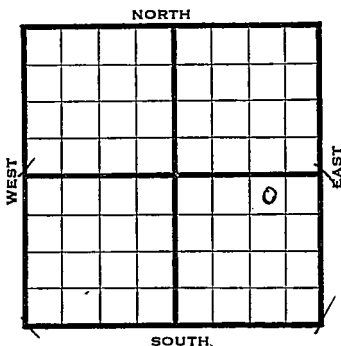

1942

REPORT

9/9 Location

9/16 8" @ 158 WOC

9/23 Drilling 3350'

9/30 TD 3802 WOC. 5" - 3799

Base KC 3738 Congl. 3764

Simp 3781 Arb. ~~3793~~ 3793

10/7 Arb. 3793 (Corrected

TD 3805 - 500' oil

10/14 " "

10/21 Arb 3793 corrected TD 3805-500 oil

10/28 Arb. 3793'

5" - 3794

2000 acid

Echo Pot. 3000'

T.D. 3805'

Gravity 29.3

COMPLETED


Graham

KANSAS

Map No. 65 Sec. 22 Twp. 9 R. 21 WWell No. 1 SutorCities Service Oil Company**FIRST REPORT** Contractor

NW NE SE

SECTION PLAT

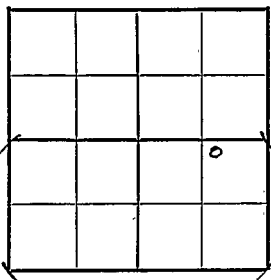330 Ft. from N. Line Ft. from S. Line990 Ft. from E. Line Ft. from W. Line

MOREL POOL

Location XXXRig up Drilling and Remarks:

RECORD

Cased in., ft.Sand Gas Oil Total Depth

PRODUCTION

1st 24 hrs. Nat. 1st 24 hrs. after shot Gas Cu. Ft.Dry Hole Abandoned

Date

SEP 9 1942 19 S. J. LEWIS Scout

Map No. 65 Sec. 22 Twp. 9 R. 21WWell No. 1 Sutor

Cities Service Oil

Company

COMPLETED

Contractor

SECTION PLAT


330 NW NE SE
Ft. from N. Line

Ft. from S. Line

990 Ft. from E. Line

Ft. from W. Line

MOREL POOL

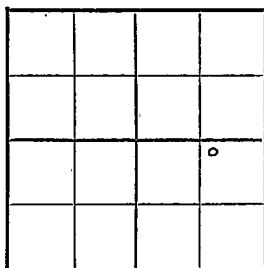

Location _____

Rig up _____

Drilling and Remarks:

*Acid 3798**5" @ 3794**2000 acid**Echo P 3000**29³ gr*

RECORD

Cased _____ in., _____ ft.

Sand _____

Gas _____

Oil _____

Total Depth *3885*

PRODUCTION

1st 24 hrs. Nat. _____

1st 24 hrs. after shot _____

Gas _____ Cu. Ft.

Dry Hole _____

Abandoned _____

Date

OCT 28 1942

19

S. J. LEWIS

Scout