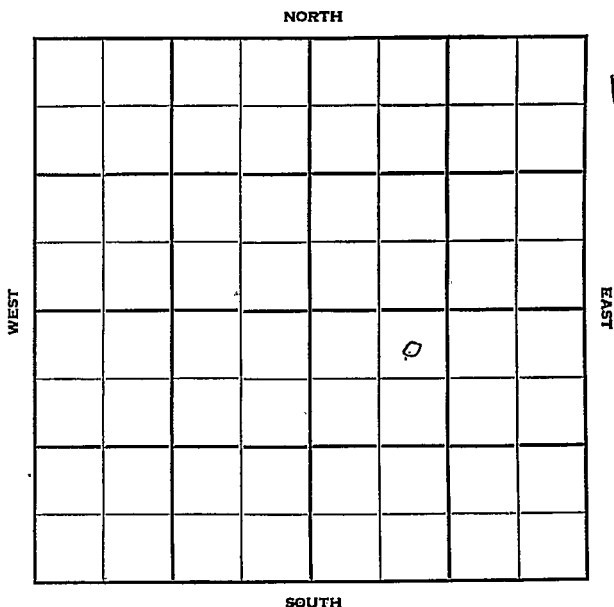


Section 22 Township 9 Range 21WWell No. #2-A
#7 SutorCompany Peel-Hardman

Graham

KANSAS

Sec. 22 Twp. 9 R. 21 W

Well No. # ²/₁ Sutor "A" Farm

Peel-Hardman Company

Peel-Hardman Contractor


Morel

330 Ft. from N. Line

 Ft. from S. Line

 Ft. from E. Line

990 Ft. from W. Line

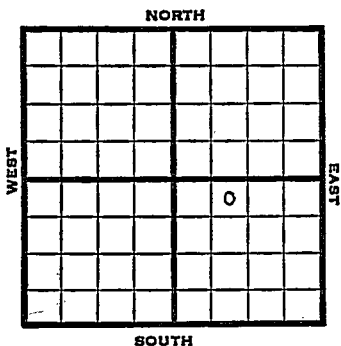

NE NW SE

CSO - Farmout

1951 Elev. 2295' REPORT

10/10 RUR

11/21 Spud 10-10-51
Oil well TD 3796' 8" @ 197
Heeb 3455' Lans. 3494' B KC 3714'
Simp. 3764' Arb. 3794'
TD 3796' 5" @ 3795' CO to 3796'
S/16 BOPH
Comp. 509 BOPD

COMPLETED

County Graham State KansasSec. 22 (Blk.) 9 (Sur.) 21W Map No.Operator Peel - HardmanWell No. 1 Farm SutorElev. Location NE NW SE

FIRST REPORT									

330 Ft. From N Line SE990 Ft. From W Line Quarter1st. Report OCT 10 1951

Completion

Remarks CSO - F.O.Peel-Hardman - Contr.

Spudding Date

Drlg. Data MorelRUR

J. E. TYRA

Kansas

Map No. _____ Sec. 22 Twp. 9 R. 21WWell No. 2 Sutor "A"Peel - Hardman Company**CORRECTION**NE NW SE Contractor

SECTION PLAT

330 Ft. from N. Line Ft. from S. Line Ft. from E. Line990 Ft. from W. Line

		0	

Graham County

RECORD

Location _____

Rig up _____

Drilling and Remarks:

Reported

#1 Sutor

Cased _____ in., _____ ft.

Sand _____

Gas _____

Oil _____

Total Depth _____

PRODUCTION

1st 24 hrs. Nat. _____

1st 24 hrs. after shot _____

Gas _____ Cu. Ft.

Dry Hole _____

Abandoned _____

Date

NOV 7 1951 19J. E. TYRAN

Scout

