

KANSAS

Graham

Section 22 Township 9 Range 21W

Well No. 1 Sutor "A"

Company Peel & Hartman

Morel

NORTH

							0

WEST

EAST

SOUTH

9

KANSAS

Graham

Sec. 22 Twp. 9 R. 21W

Well No. #1 Sutor "A" Farm

Peel & Hartman Company

Morel Pool


NORTH

330' Ft. from N. Line

_____ Ft. from S. Line

330' Ft. from E. Line

_____ Ft. from W. Line

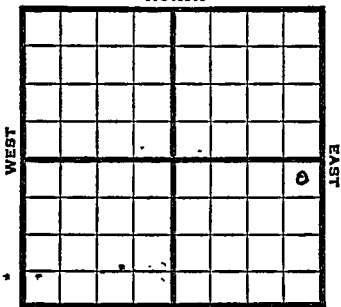

NE SE

SOUTH

1949 Eley 2293' REPORT

- 4/13 Anhy. 1748'
- 8" @ 161'
- 4/20 Drlg. 3000'
- Lansing 3489'
- BKC 3710'
- Arb. 3787'
- TD 3790'
- 5₂@ 3789'
- 4/27 TD 3793'
- 500 acid
- 5/4 "
- 5/10 "
- 5/18 "
- 5/25 "
- 6/1 "
- 6/8 Arb. 3787'
- 5" @ 3789'
- TD 3793'
- 1000 acid
- Echo Pot 3000' oil
- 30° Gr.
- Comp

COMPLETED

Map No. _____ Sec. 22 Twp. 9 R. 21W

Well No. 1 Sutor "A"

Peel & Hartman Company

FIRST REPORT

Contractor

NE SE


SECTION PLAT

330 Ft. from N. Line

_____ Ft. from S. Line

330 Ft. from E. Line

_____ Ft. from W. Line

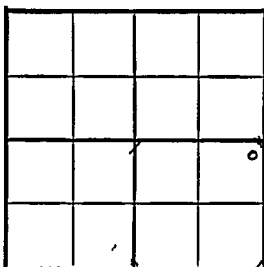

Graham County

Location _____

Rig up _____

Drilling and Remarks:

Anhy 1748

8" @ 161

drlg. 3000

RECORD

Cased _____ in., _____ ft.

Sand _____

Gas _____

Oil _____

Total Depth _____

PRODUCTION

1st 24 hrs. Nat. _____

1st 24 hrs. after shot _____

Gas _____ Cu. Ft.

Dry Hole _____

Abandoned _____

Date

APR 13 1949 19

S. J. LEWIS

Scout

