

Graham

KANSAS

SECTION 22 TOWNSHIP 9 RANGE 23 W

WELL NO. #1 Goodard

COMPANY Petroleum Inc.

NORTH

	0						

WEST

EAST

SOUTH

4

Graham

KANSAS

SEC.	TWP.	R.
22	9	23W

WELL NO.

#1 Goddard

FARM

COMPANY

Petroleum Inc.

CONTRACTOR

Garvey


_____ Ft. from N. Line

_____ Ft. from S. Line

_____ Ft. from E. Line

_____ Ft. from W. Line

NE NW NW

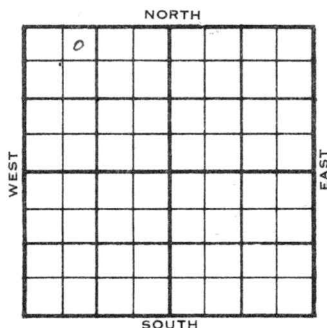

	ELEVATION	REPORT
1955		
11-30	Comm. 11-25-55 8" @ 227/125 Drlg. 1766	

 Sec. 22 Twp. 9 Rge. 23W
 Company Petroleum Inc.
 Farm Name Goddard No. 1

TOPS	DEPTH	LOG	DATUM	Loc. in Sec.
Arb	1956			100 100 100
Tr.	3667			
Dg				
BL				
L.	3683		1339	Geol.
K.C.				
B.K.C.	3907		1563	Conte
Ce. <u>MARIN</u>	4000		1656	Survey
C.				
M.	4127		1783	Pool
M.				Evergreen
K.				
Ms.				
Me				
V.				
S.	4207		1863	
S.				
A.	4219		1875	
R.				
PE.				
G.				
TR	4245			

Date Comm. 11-25-55 FEB 15 1956

0" @ 227/125 drl. 1766 DEC 7 '55 DST

3689-3735 or 1 hr rec 1480'
 VSOC SW BHP 1250 FP 480-750
 DST 3702-11 or 30" rec 12' Md
 (sprks oil) BHP 0/20" DST 3739-60
 or 1 hr rec 45' 05' GCM + 60' HO
 & GCM + 70' Muddy oil + 50' oil & wtr
 FP 40-120 BHP 1250/20 DST
 3698-3718 or 1 hr rec 100' HO & GCM

+ 120' V40' GCM FPO-100
BHP 1250/20" ~~D~~ ahead.
DEC 14 '55 DST 3798-3813 30"
rec 15' Md BHP 40/20
DST 3835-95 or 30" rec
15' Md BHP 0/20 DST
4167-88 45" rec 200' MSW
BHP 1140/20" 5 1/2 3860/75
DEC 21 '55 CO 3799 1/2 4/3716-16 1/2
tst 25 Boph 1/2 sad. CO
3799 16/3758-62 tst 1.6
Boph 1/2 old PFS broke
in sad. CO DEC 28 '55 CO 3754
8/3749-51 tst 9 BW (oil sking)
PI9 3720 8/3711-13 no rec
1/2 Tst 3 1/2 BF 15% W 1 hr
1/2 \$ av. 18 BFph 18%
Wtr. Tstg JAN 5 '56 ✓ JAN 11 '56 ✓
JAN 18 '56 JAN 25 '56 W. pot FEB 1 '56 ✓ FEB 8 '56
P. 74 BF 64% Wtr 24
hrs FEB 15 '56 Ph P 30 Bopd
+ 60% Wtr

R.G.

FEB 27 1956