KANSAS


FORM 51 25M 3-49 PETROL Graham

Section 22 Township 9 Range 23W

Well No. #1 E. E. Goddard

Company Harry Gore et al

6

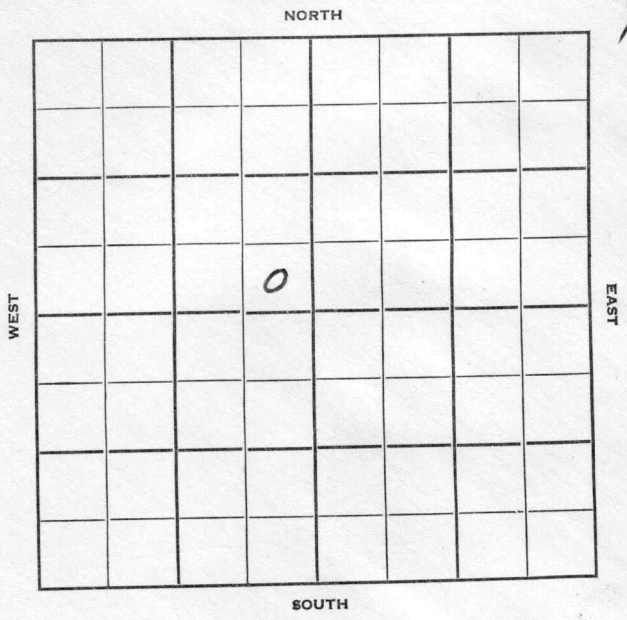

FORM 252-B
10M 10-50 PETROL

Graham KANSAS ✓

Sec. 22 Twp. 9 R. 23W

Well No. #1 E. E. Goddard Farm

Harry Gore et al Company

Empire - Contr. Contractor

Wildcat


Ft. from N. Line

330' Ft. from S. Line

330' Ft. from E. Line

Ft. from W. Line

SE SE NW

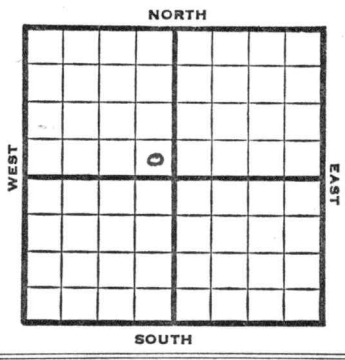

1952	Elev. 2380' REPORT
7/16	Spud 7-12-52 8" @ 197 Anhy 1980 Drlg. 2035
7/23	Heeb. 3688 Lans. 3725 B KC 3966 Drlg. 3980'
7/30	Spud 7-12-52 D & A TD 4296' 8" @ 197 Anhy 1980' Heeb 3688' Lans. 3725' B KC 3966' Marm. 4056' Cong. 4159' Arb. 4273' TD 4296' D & A ABANDONED

FORM 275 FOR SALE BY KANSAS BLUE PRINT CO.


County Graham State Kansas

Sec. 22 (Blk.) (Twp.) 9 (Sur.) (Rge.) 23W Map No.

Operator Harry Gore etal.

Well No. 1 Farm E. E. Goddard

Elev. 2380 Location SE SE NW

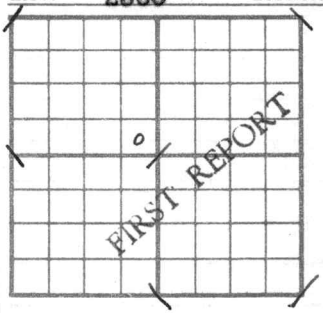

330 Ft. From S Line NW

330 Ft. From E Line Quarter

1st. Report JUL 16 1952

Completion

Remarks Magnolia - DHM

Empire - Contr.

Spudding Date 7-12-52

Drlg. Data Wildcat

8" @ 197 Anhy 1980 Drlg. 2035

J. G. McGEHEE

FORM 275 FOR SALE BY KANSAS BLUE PRINT CO.

County Graham State Kansas

Sec. 22 (Blk. Twp.) 9 (Sur. Rge.) 23W Map No.

Operator Harry Gore etal.

Well No. 1 Farm E. E. Goddard

Elev. 2380 Location SE SE NW



330 Ft. From S Line NW

330 Ft. From E Line Quarter

1st. Report

Completion JUL 30 1952

Remarks Wildcat

Empire Drlg. - Contr.

Spudding Date 7-12-52

Drlg. Data D & A TD 4296

8" @ 197 Anhy 1980 Heeb. 3688

Lans. 3725 B KC 3966 Marm. 4056

Cong. 4159 Arb. 4273 TD 4296

D & A

J. G. McGEHEE