FORM 51 10M 8-47


KANSAS Rooks

Section 23 Township 9 Range 19-W

Well No. #1 Gerrow

Company Stanolind

Saindon Pool

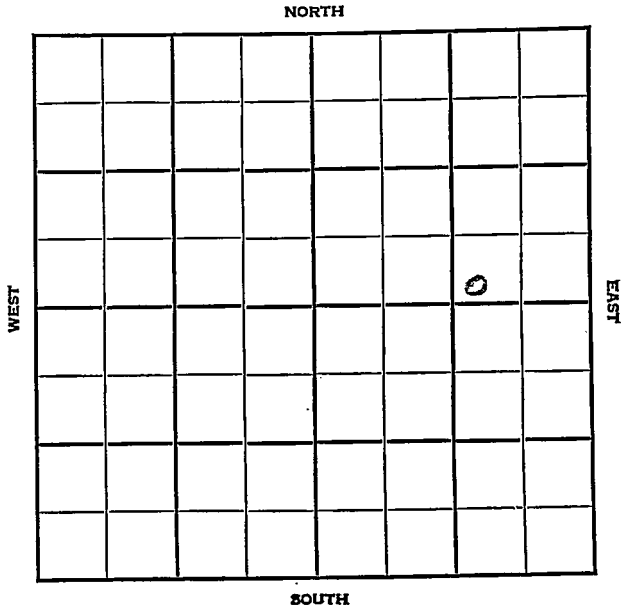

FORM 252-A
5M 4-48 PETROL

KANSAS Rooks

Sec. 23 Twp. 9 R. 19W

Well No. #1 Gerrow Farm

Stanolind Company

Saindon Pool


Ft. from N. Line

330' Ft. from S. Line

990' Ft. from E. Line

Ft. from W. Line

SW SE NE

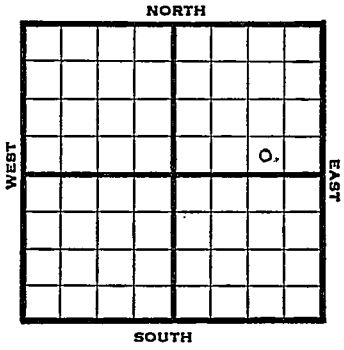

1948	Eli 2119' REPORT
6/16	Drlg. 1700'
6/23	Lansing 3292' Drlg 3480'
6/29	Arbuckle 3536' TD 3541' 6" @ 3538' RUST
7/14	TD 3547' Arb. 3536' 6"@ 3538' 2000 acid Depth Pot 2960' 24° Gr. Comp COMPLETED

Form 26—200 Bks.—1-48—Palace

Saindon Pool

Kansas.

Map No. _____ Sec. 23 Twp. 9 R. 19W


Well No. 1 Cerrow

Stanolind Company

FIRST REPORT Contractor

SW SE NE

SECTION PLAT

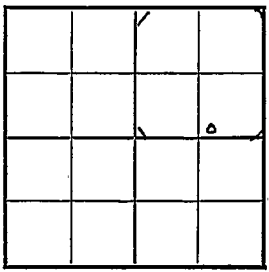

_____ Ft. from N. Line

330 Ft. from S. Line

990 Ft. from E. Line

_____ Ft. from W. Line

Rooks County

Location _____

Rig up _____

Drilling and Remarks:

drlg. 1700

RECORD

Cased _____ in., _____ ft.

Sand _____

Gas _____

Oil _____

Total Depth _____

PRODUCTION

1st 24 hrs. Nat. _____

1st 24 hrs. after shot _____

Gas _____ Cu. Ft.

Dry Hole _____

Abandoned _____

Date

JUN 16 1948 19____ _____ Scout

Saindon Pool

Form 26—200 Bks.—1-48—Palace

Kansas

Map No. 64 Sec. 23 Twp. 9 R. 19W

Well No. 1 Cerrow


Stanolind Company

COMPLETE Contractor

SW SE NE

E 12118

SECTION PLAT

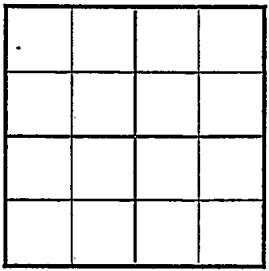

Ft. from N. Line

330 Ft. from S. Line

990 Ft. from E. Line

Ft. from W. Line

Rooks County

Location

Rig up

Drilling and Remarks:

Cr 3536

6" @ 3588

2000 gal acid

DST #1 3 2960

2402 Gr

RECORD

Cased in., ft.

Sand

Gas

Oil ✓

Total Depth 3548

PRODUCTION

1st 24 hrs. Nat.

1st 24 hrs. after shot

Gas Cu. Ft.

Dry Hole

Abandoned

Date

JUL 14 1948 19

S. J. LEWIS Scout